


KANSAS CORPORATION COMMISSION

WELL RECORD

(Mail to Kansas Geological Survey, 4150 Monroe Street, Wichita, Kansas 67209)

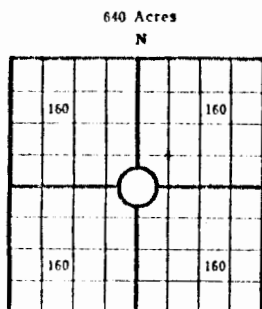

Locate well correctly

18-27-21W h
API # 15-057-20,040

Lease Name: Bolinger 'E' Well No. 1
 Well Located: C SE SE
SEC 18 TWP 27 RGE 21W
 Operator: Donald C. Slawson
 Address: 408 One Twenty Building- Wichita, Kansas 67202
 Elevation: Ground 2388 D.F. 2390 K.B. 2393
 Type Well: (Oil, gas, dry hole) Dry Hole

Drilling Commenced: August 8, 19 72 Drilling Completed: Sept. 9, 19 72
 Well Completed: Sept. 9, 19 72 Total Depth 5146'
 Initial Production: _____

Casing Record

Size: 8 5/8" Set at 398' Size: _____ Set at _____
 Size: _____ Set at _____ Size: _____ Set at _____

Liner Record

Size: _____ Set from _____ To _____

Cementing

Casing Size	Sacks	Type Cement and Additives
<u>8 5/8"</u>	<u>400 sx</u>	<u>60-40 Poz with 3% HA-5</u>
_____	_____	_____
_____	_____	_____

Perforations

Formation	Perforated Interval and Number Shots
_____	_____
_____	_____
_____	_____
_____	_____

Electric Log Run (Show type log and depths covered)

SCHLUMBERGER = Laterlog, Gamma Ray, Neutron (398-5146)

18-51

Show Drill Stem Tests,
Well Stimulation and
Production Tests

18-27-21w

Formation Top Bottom

Surface Hole	0	404
Shale & Shells	404	931
Shale & Lime	931	1428
Anhydrite	1428	1469
Shale & Lime	1469	1688
Shale & Shells	1688	2460
Lime & Shale	2460	3800
Lime	3800	4025
Lime & Shale	4025	4180
Lime	4180	4280
Lime & Shale	4280	4311
Lime	4311	4985
Mississippian	4985	5146

TD

5146

DST #1 (5005-27) Op 30", SI 30"; Op 45", SI 60"
SB 2400' GIP Rec. 160' MGO, 30' MOCW
BHP: 1229#/1213# FP: 15-47#/47-78#

