

STATE CORPORATION COMMISSION OF KANSAS
OIL & GAS CONSERVATION DIVISIONWELL COMPLETION OR RECOMPLETION FORM
ACO-1 WELL HISTORY

DESCRIPTION OF WELL AND LEASE

Operator: License # 6668 & 7302
 Name Theodore I. Leben & Sylvan Oil Operating Co.
 Address 105 South Broadway, Suite 640
 City/State/Zip Wichita, Kansas 67202

Purchaser.....

Operator Contact Person David Leben
 Phone 316-264-2375

Contractor: License # 5302
 Name Red Tiger Drilling Company

Wellsite Geologist Gerald Zorger
 Phone 316-264-2375

Designate Type of Completion

☒ New Well ☐ Re-Entry ☐ Workover

☐ Oil ☐ SWD ☐ Temp Abd
☐ Gas ☐ Inj ☐ Delayed Comp.
☒ Dry ☐ Other (Core, Water Supply etc.)

If OWWO: old well info as follows:

Operator
 Well Name
 Comp. Date Old Total Depth.....

WELL HISTORY

Drilling Method:

☒ Mud Rotary ☐ Air Rotary ☐ Cable

11/11/86 11/21/86 11/22/86
 Spud Date Date Reached TD Completion Date
 5,050'
 Total Depth PBTD

Amount of Surface Pipe Set and Cemented at 569.02 feet
 Multiple Stage Cementing Collar Used? ☐ Yes ☒ No
 If yes, show depth set.....feet
 If alternate 2 completion, cement circulated
 from.....feet depth to.....w/.....SX cmt

API NO. 15-057-20,423

County Ford

C NW/4 NW/4 25 27S 21W ☐ East
 Sec. Twp. Rge. ☒ West

4620 Ft North from Southeast Corner of Section
 4620 Ft West from Southeast Corner of Section

(Note: Locate well in section plat below)


Lease Name Tracy Well # 1-25

Field Name.....

Producing Formation.....

Elevation: Ground 2332 KB 2337

Section Plat

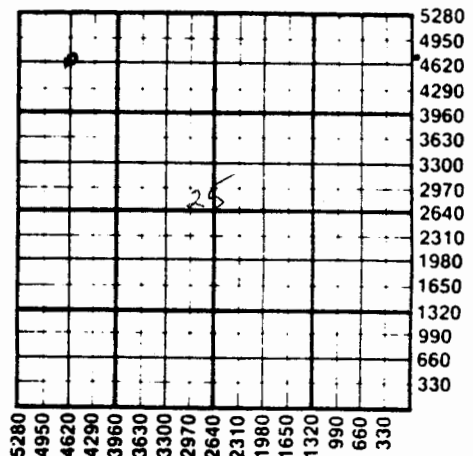

WATER SUPPLY INFORMATION

Disposition of Produced Water: ☐ Disposal
 Docket # ☐ Repressuring

Questions on this portion of the ACO-1 call:

Water Resources Board (913) 296-3717

Source of Water:

Division of Water Resources Permit # T. 86-367

☒ Groundwater 4620 Ft North from Southeast Corner
 (Well) 4620 Ft West from Southeast Corner of
 Sec 25 Twp 27S Rge 21 ☐ East ☒ West

☐ Surface Water.....Ft North from Southeast Corner
 (Stream, pond etc).....Ft West from Southeast Corner
 Sec Twp Rge ☐ East ☐ West

☐ Other (explain).....
 (purchased from city, R.W.D. #)

INSTRUCTIONS: This form shall be completed in duplicate and filed with the Kansas Corporation Commission, 200 Colorado Derby Building, Wichita, Kansas 67202, within 90 days after completion or recompletion of any well. Rule 82-3-130 and 82-3-107 apply.
 Information on side two of this form will be held confidential for a period of 12 months if requested in writing and submitted with the form. See rule 82-3-107 for confidentiality in excess of 12 months.
 One copy of all wireline logs and drillers time log shall be attached with this form. Submit CP-4 form with all plugged wells. Submit CP-111 form with all temporarily abandoned wells.