

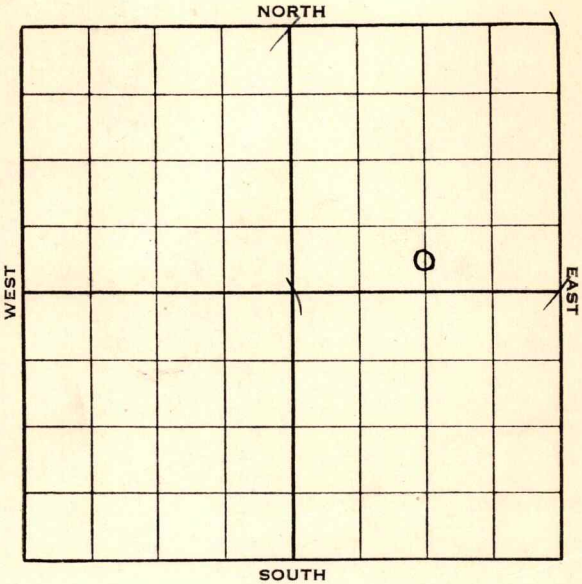
Ford KANSAS

O.W.W.O.

Section 34 Township 27 Range 21-W

Well No. 1 Young

Company ~~Sinclair-prairie~~ Rufus clay

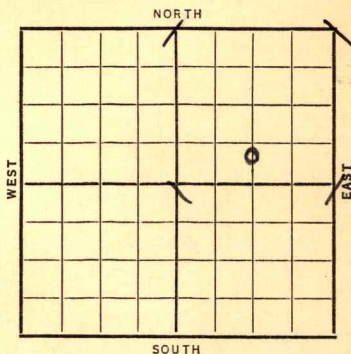


Sec. 34 Twp. 27 R. 21-W ✓Well No. #1 Young FarmSinclair-Prairie Refining Clay Company**O.W.W.O.**

_____ Ft. from N. Line

33-440 Ft. from S. Line1320 Ft. from E. Line

_____ Ft. from W. Line

**Eleg. 2330**

Date	REPORT
1938	
3/9	Location
3/18	B.R.R.
3/25	R U R
4/1	15" @ 250'. WOC.
4/8	Drlg. 2300'.
4/15	Drlg. 2830'.
4/22	Drlg. 3790'.
4/29	Fort Riley. 2698'.
	K.C. 4280'. Drlg. 4600'.
5/3	Top Miss. ⁴⁸⁹⁰4892 Cored 4991-93
	Recovered 2 feet
	1' green shale & 1' lime Show oil & gas T.D. 4993 Running Halliburton test (Tel)
5/12	Sm. S.O. 4995-98'. SD @ 5105'
	for repairs.
	Miss. 4890' (Corrected)
5/20	Drlg. 5350'.
	OVER

1938

5/27 **Viola 5350'**. T.D. 5512'.
No shows. Reaming core hole.
" " " " " "

6/3
6/10 **Wilcox 5617'**. **Stain oil &**
sulphur odor in core 5620-30'.
Arb. 5629'. Coring.

6/17 T.D. 5925'. No shows.
Will make drill stem test.

6/24 T.D. 5930'. Drill stem test
recorded S. O. 4265-80' S. O.
or gas 4889-4905'.
S. O. 4990-5012'.
S. W. in viola.
S. O. 5615-24 in Wilcox.
S. W. 5624-27'.
S. O. 5632-37 & 5642-48' in Arb.
Will P. B.

7/1 P.B. 5025' Rng. 7"

7/8 7" - 4886'. C. O.

7/14--Drilled plugs Bailed 1/2 bbl. oil &
4½ bbls. water in 8 hours
Acidized with 9000 gallons
Bailed down 1200' off bottom
Started flowing Spraying oil mud and
water (Tel)

7/15 Flowing Est. 6 to 10 oil & 20
wtr. per hr. with 10 to 12 M gas

7/22 Gas decreased to 4 M & oil to
2 to 3 bbls. per hr. with 6
bbls. water per hour. 2000 acid.

7/29 Shut in.

8/5 " "

8/12 " "

OVER

1938

8/19 Shut in.

8/26 " "

9/2 " "

9/9 " "

9/16 " "

9/21 7" at 4886'.

Arb. 5629'.

T. D. 5930'.

Miss. 4890'.

P. B. 5025'.

6 M gas & 3 oil & 6 water per
hour.

COMPLETED

1950

O.W.W.O.

9/20 Miss 4890' Viola 5350'

Simp. 5542' Arb. 5629'

OTD 5930' 7" @ 4886'

To PB and test Miss.

9/27 Miss 4890 Viola 5350

Simp 5542 Arb 5629

OTD 5930

7" @ 4886

PB 5025 $\frac{1}{2}$ F/250 bf 12 hr Est 45 bo

Comp 35 bopd 175 bw $\frac{1}{2}$ mcfgpd

TD 5025 $\frac{1}{2}$

Completed

COMPLETED

Well No. _____ Farm _____

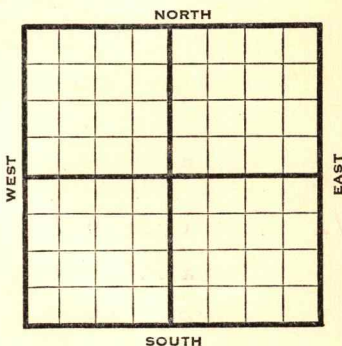
Company

_Ft. from N. Line

Ft. from S. Line

Ft. from E. Line

_Ft. from W. Line



REPORT

[illegible]

O.W.W.O.

County Ford State KansasSec. 34 (Blk. 27 (Sur. 21W Map No. 21W)
(Twp.) (Rge.)Operator Ruffas ClayWell No. 1 Farm YoungElev. _____ Location C S L NE

330 Ft. From S Line NE1320 Ft. From E Line Quarter1st. Report SEP 20 1950

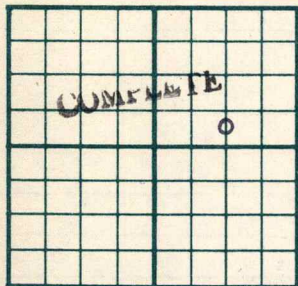
Completion _____

Remarks OWWO

Spudding Date _____

Drlg. Data WildcatMiss. 4890 Viola 5350 Simp. 5542Arb. 5629 OTD 5930 7" @ 4886To PB and test Miss.

J. E. TYRA

County Ford State KansasSec. 34 (Blk. 27) (Sur. 21W) Map No.Operator Ruffas ClayWell No. 1 Farm YoungElev. Location C S L NE330 Ft. From S Line NE1320 Ft. From E Line Quarter

1st. Report

Completion SEP 27 1950Remarks OWWOWildcat

Spudding Date

Drlg. Data Oil well TD 5025 $\frac{1}{2}$ Miss. 4890 Viola 5350 Simp. 5542Arb. 5629 OTD 5930 7" @ 4886PB 5025 $\frac{1}{2}$ F/ 250 bf 12 hr. Est 45 boComp. 35 bopd 175 bw $\frac{1}{2}$ mcf gpd

J. E. TYRA

Ford

KANSAS

Map No. 90 Sec. 34 Twp. 27 R. 21WWell No. 1 YoungSinclair Prairie

Company

Contractor

FIRST REPORT

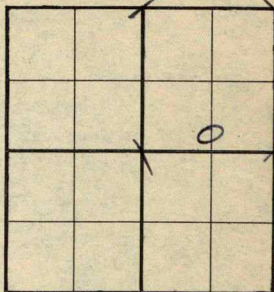
C S L N E

Ft. from N. Line

440 Ft. from S. Line1320 Ft. from E. Line

Ft. from W. Line

SECTION PLAT

Location X

Rig up

Drilling and Remarks:

RECORD

Cased _____ in., _____ ft.

Sand _____

Gas _____

Oil _____

Total Depth _____

PRODUCTION

1st 24 hrs. Nat. _____

1st 24 hrs. after shot _____

Gas _____ Cu. Ft.

Dry Hole _____

Abandoned _____

Date

MAR 9 - 1938

19

H. D. Hatfield Scout

Map No. 90 Sec. 34 Twp. 27 R. 21WWell No. 1 YoungSinclair Prairie

Company

Contractor

C S L N E

 Ft. from N. Line440 Ft. from S. Line1320 Ft. from E. Line Ft. from W. Line

SECTION PLAT

Location Rig up

Drilling and Remarks:

MISS 4890P.B. 50256 M gas4 3 oil x 6 wtrP.H.

RECORD

Cased 7 in., 4886 ft.Sand ARB 5629Gas Oil Total Depth 5930

PRODUCTION

1st 24 hrs. Nat. 1st 24 hrs. after shot Gas Cu. Ft.Dry Hole Abandoned

Date

SEP 21 1938

19

Scout

Nathaniel
By: Paul