


KANSAS

Ford

Section 35 Township 27 Range 21-W

Well No. #1 Birney

Company Rufus Clay

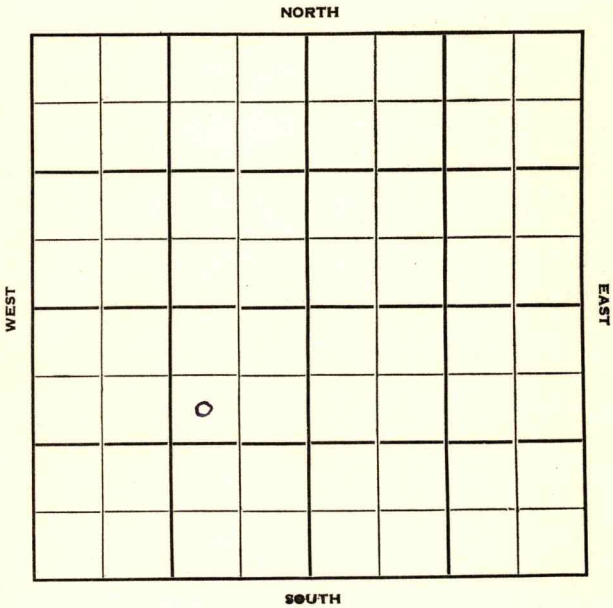

Ford

KANSAS

Sec. 35 Twp. 27 R. 21W

Well No. #1 Birney Farm

Rufus Clay Company

Harbar Drlg. - Contr. Contractor

Pleasant Valley Pool


990' Ft. from N. Line

 Ft. from S. Line

990' Ft. from E. Line

 Ft. from W. Line

SW NE SW

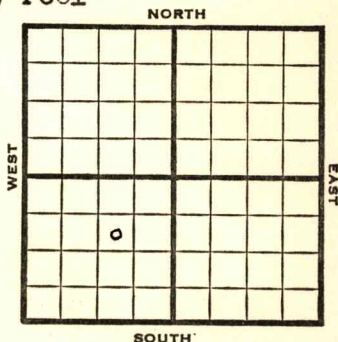

1950

Elev. 2334'

R E P O R T

12/27 RUR

1951

6/20

Spud 12-29-50

D & A TD 5015' 8" @ 329'

KC 4276'

DST 4280-4320' open 1/2 hr. rec 1440' SW

Miss. 4905'

DST 4907-80 open 1 hr. rec 560' GCM

DST 4980-5015' open 1 hr. rec 360' mud,
450' water TD 5015' 5" @ 5015'

59/4904-20 12/4971-84 35/4906-16

64/4904-20 240/4926-86 4000 A

150,000 gas Perf/4905-16 4928-49

4952-86 SP 4923 48/4925-37

2000 A 16/4946-50 16/4952-56

32/4961-69 24/4927-35 4000 A

B/15 GW SSO & gas 36/4904-16

12/4946-50 12/4952-56 24/4961-69

8000 A S/80 GFPH 25% oil

65 qt/4910-70 SP 4776' 20/4627-32

56/4636-50 2000 A S/4 BW 1 BOPH

5000 A D & A

ABANDONED

County Ford State Kansas
 Sec. 35 (Blk.) 27 (Sur.) 21W Map No.
 Operator Rufus Clay
 Well No. 1 Farm Birney
 Elev. Location SW NE SW

FIRST REPORT

990 Ft. From N Line SW
 990 Ft. From E Line Quarter
 1st. Report DEC 27 1950

Completion

Remarks

Harbar Drlg. - Contr.

Spudding Date

Drlg. Data

Pleasant Valley Pool

RUR

J. E. TYRA

County	Ford		State	Kansas	
Sec.	35	(Blk. Twp.)	27	(Sur. Rge.)	21w Map No.
Operator	Rufus Clay				
Well No.	1	Farm	Birney		
Elev.	2334	Location	SW NE SW		
			990 Ft. From N Line	SW	
			990 Ft. From E Line	Quarter	
			1st. Report		
			Completion	JUN 20 1954	
			Remarks	Pleasant Valley Pool	
			Harbar Drlg. - Contr.		
			Spudding Date	12-29-50	
Drlg. Data	D & A		TD 5015		

8" @ 329 KC 4276 DST 4280-4320

open $\frac{1}{2}$ hr. Rec. 1440' sw Miss. 4905

DST 4907-80 open 1 hr. Rec. 560' gcm

DST 4980-5015 open 1 hr. Rec. 360' mud

450' water TD 5015 5" @ 5015

59/ 4904-20 13/ 4971-84 35/ 4906-16

64/ 4904-20 240/ 4926-86 4000 A

150,000 gas Perf/ 4905-16 4928-49

4952-86 SP 4923 48/ 4925-37 2000 A

16/ 4946-50 16/ 4952-56 32/ 4961-69

24/ 4927-35 4000 A B/ 15 gw SSo & gas

36/ 4904-16 12/ 4946-50 12/ 4952-56

24/ 4961-69 8000 A S/ 80 gfph 25% oil

65 qt/ 4910-70 SP 4776 20/ 4627-32

J. E. TYRA

Drlg. Data

56/ 4636-50 2000 A S/ 4 bw 1 boph

5000 A D & A

JUL 6 1951

JUL 6 1951

Misc. _____
France Map _____
Tracings _____
Land Wall Map _____
Land Small Map _____
Scout Cards _____

Misc. _____
Pierce Map _____
France Map _____
Tracings _____
Land Wall Map _____
Land Small Map _____
Scout Cards _____

[Handwritten signature]