

Stanton

Section 21 Township 27 Range 40W

Well No. #4 Winger

Company United Production

NORTH

							.
				0			

WEST

EAST

SOUTH

Stanton

KANSAS

Sec. 21 Twp. 27 R. 40 W.

Well No. # 4 Winger Farm

United Production Company

Contractor

Hugoton Pool


150 Ft. from N. Line

\_\_\_\_\_ Ft. from S. Line

\_\_\_\_\_ Ft. from E. Line

150 Ft. from W. Line

NW SE

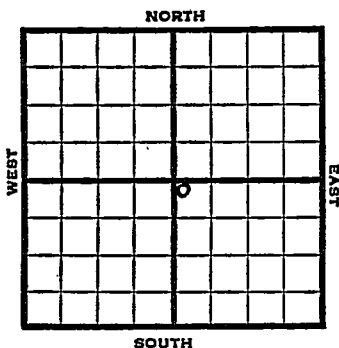

1951

Elev. 3249' REPORT

3/7

Spud 3-3-50  
10" @ 397  
Drilling 1100'

4/11

Spud 3-3-50  
Gas Well TD 2380  
10" @ 397  
7" @ 2250  
TD 2380'  
Her. 2247-60 Krider 2260-73  
Win. 2287-2330 Ft. Riley 2368  
7500 A Comp. 19,300,000 gas 421#

**COMPLETED**



