


Section 21 Township 27 Range 5W

Well No. #1 Wimer

Company Texas Co.

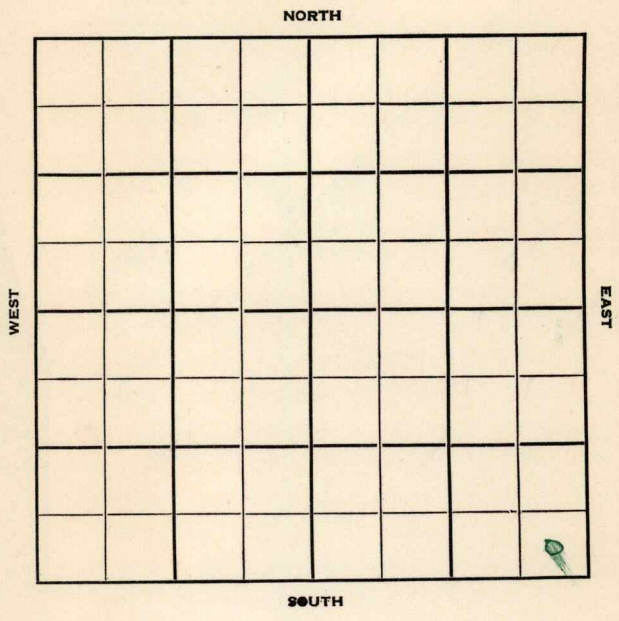

Kingman

~~KANSAS~~

Sec. 21 Twp. 27 R. 5W

Well No. #1 Wimer Farm

Texas Co. Company

Laura Jane-Contr. Contractor


 Ft. from N. Line

330' Ft. from S. Line

330' Ft. from E. Line

 Ft. from W. Line

SE SE SE

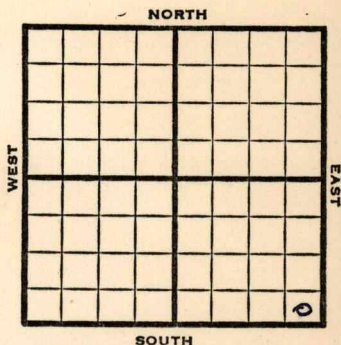

1951

Elev. 1484' REPORT

11/14

Spud 11-10-51
10" @ 253
Drlg. 915

1952
1/2

Spud 11-10-51
D & A TD 3822' 10" @ 253
Top. 2353' Heeb 2690' Br. lime
2957' Lans. 2987' Miss 3762'
Dol. 3801'
DST 3801-07 open 1½ hr. rec 30' GCM
60' salty GCM
DST 3789-3807' open 1 hr. rec 100'
GCM, 350' GCM & SSO, 200' SW
TD 3807' 7" @ 3807' 5/3797-3803
S/3 BFPH mostly water DD 3822'
S/5 BWPB PB 3750 CO to 3796
13/3788-92 S/2 BW 1 hr.
S/½ BW & SSO 1 hr. CO to 3801
24/3796-3800 FU 5 GOPH 500 A
S/12 BFPH & SO
D & A

ABANDONED

County Kingman State Kansas
 Sec. 21 (Blk.) 27 (Sur.) 5W Map No.
 Operator Texas Company
 Well No. 1 Farm Wimer
 Elev. 1484 Location SE SE SE



330 Ft. From S Line SE

330 Ft. From E Line Quarter

1st. Report

Completion JAN 2 1952

Remarks

Laura Jane - Contr.

Spudding Date 11-10-51

Drilg. Data D & A TD 3822

10" @ 253 Top. 2353 Heeb. 2690

Br. lime 2957 Lans. 2987 Miss. 3762

Dol. 3801 DST 3801-07 open 1½ hr.

Rec. 30' gcm 60' salty gcm DST 3789-3807

open 1 hr. Rec. 100' gcm 350' gcm & SSO

200' sw TD 3807 7" @ 3807 5/ 3797-3803

S/ 3 bfph mostly water DD 3822 S/ 5 bwph

PB 3750 CO to 3796 13/ 3788-92

S/ 2 bw 1 hr. S/ ½ bw & SSO 1 hr.

CO to 3801 24/ 3796-3800 FU 5 goph

500 A S/ 12 bfph & SO

D & A

J. E. TYRA

County **Kingman** State **Kansas**Sec. **21** (Blk. **27** (Sur. **5W** Map No. (Twp.) (Rge.)Operator **Texas Company**Well No. **1** Farm **Wimer**Elev. Location **SE SE SE****330** Ft. From **S** Line **SE****330** Ft. From **E** Line Quarter1st. Report **NOV 14 1951**

Completion

Remarks

Laura Jane - Contr.Spudding Date **11-10-51**

Drlg. Data

10" @ 253 Drlg. 915**J. E. TYRA**