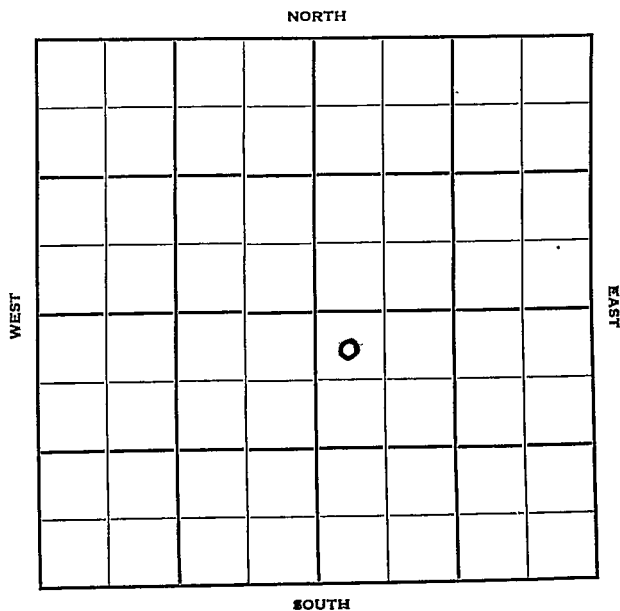


Section 21 Township 27 Range 12 WWell No. # 1 AllenCompany ~~LION~~
Lindas Oil

Pratt

Sec. 21 Twp. 27 R. 12W

Well No. #1 Allen Farm

Lion
Lindas Oil

Company

Lindas - Contr.

Contractor


330' Ft. from N. Line

Ft. from S. Line

Ft. from E. Line

330' Ft. from W. Line

NW NW SE

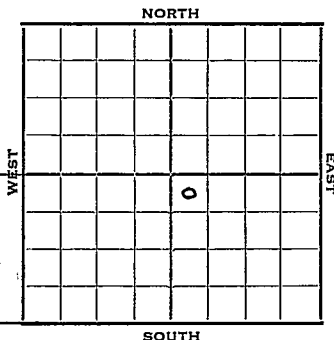

1952	1839 L&S 1842 RR	REPORT
4/30	Spud 4-25-52 13" @ 202 Anhy 606' 8" @ 796 WOC	
5/7	Heeb. 3469 Br Li 3687 Lans. 3703 Drlg. 3889'	
5/14	DST 3942-76, 3/4 hr. 2640' gas, 195' O&GCM 625# Miss. Li 4160 DST 4161-69, 1 hr. 15' m 570# V. 4319' Drlg. 4320'	
5/21	Arb. 4483 RTD 4585' 5" @ 4034'	
5/28	45/3952-64 1000 A S/9 BO & 31 BW 13 hrs. 48/3960-74 3000 A S/15 BO & 54BW 9 1/2 hrs. S/14 BO & 63 BW 12 hrs.	
6/4	Spud 4-25-52 D&A -TD 4585' 13" @ 202' Anhy 606' 8" @ 796' Heeb. 3469' Br Li 3687 Lans. 3703 DST 3942-76 open 3/4 hr. rec. 2640' gas 195' o & gcm Miss. 4160 DST 4161-69 open 1 hr. rec. 15' mud Viola 4319 Arb. 4483 TD 4585 5" @ 4034 45/ 3952-64 1000 A	

OVER

1952

6/4 S/ 9 bo 31 bw 13 hr. 48/ 3960-74
3000 A S/ 15 bo 54 bw 9 $\frac{1}{2}$ hr.
S/ 14 bo 63 bw 12 hr. S/ 19 bo
85 bw 24 hr. PB 3931 24/ 3916-24
18/ 3888-3890 2 be PB 3755
24/ 3740-48 D&A

ABANDONED

County Prett State Kansas
 Sec. 21 (Blk.) 27 (Sur.) 12W Map No.

Operator Lindas Oil

Well No. 1 Farm Allen

Elev. 1839 L&S Location NW NW SE
1842 RB

330 Ft. From N Line SE

330 Ft. From N Line Quarter

1st. Report APR 30 1952

Completion

Remarks

Lindas - Contr.

Spudding Date 4-25-52

Drig. Data MCPC has SE/4 of 20-27-12W & N/2 of
S/2 of 27-28-12W Wildcat

13" @ 202 Anhy 606 8" @ 796 W.O.C.

J. G. McGEHEE

OK

~~CONFIDENTIAL~~

6

100

[illegible]



~~MAY 2~~ 1952

Drig. Data

Map No. _____ Sec. 21 Twp. 27 R. 12WWell No. 1 Allen_____ Lion Oil _____ Company


_____ Contractor

NW NW SE

SECTION PLAT330 Ft. from N. Line

_____ Ft. from S. Line

_____ Ft. from E. Line

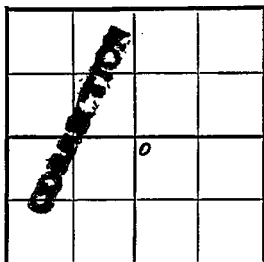330 Ft. from W. LinePratt County

Location _____

Rig up _____

Drilling and Remarks:

Reported

Lindas Oil

RECORD

Cased _____ in., _____ ft.

Sand _____

Gas _____

Oil _____

Total Depth _____

PRODUCTION

1st 24 hrs. Nat. _____

1st 24 hrs. after shot _____

Gas _____ Cu. Ft.

Dry Hole _____

Abandoned _____

Date

MAY 21 1932


J. G. MCGEEHEE

19

Scout



 


MAY 22 1952

Scout Cards	
Land Small Map	
Land Wall Map	
Tracings	
France Map	
Pierce Map	
Misc.	


County Pratt State Kansas
 Sec. 21 (Blk. Twp.) 27 (Sur. Rge.) 12W Map No. _____
 Operator Lion Oil
 Well No. 1 Farm Allen
 Elev. 1839 Location NW NW SE

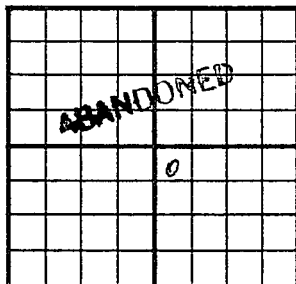

330 Ft. From N Line SE
330 Ft. From W Line Quarter
 Ist. Report _____
 Completion JUN 4 1952
 Remarks Wildcat
Lindas - Contr.
 Spudding Date 4-25-52

Drlg. Data D & A TD 4585

13" @ 202 Anhy 606 8" @ 796
Heeb. 3469 Br. lime 3687 Lans. 3703
DST 3942-76 open 3/4 hr. Rec. 2640' gas
195' o & gcm Miss. 4160 DST 4161-69
open 1 hr. Rec. 15' mud Viola 4319
Arb. 4483 TD 4585 5" @ 4034 45/ 3952-
64 1000 A S/ 9 bo 31 bw 13 hr.
48/ 3960-74 3000 A S/ 15 bo 54 bw
9 1/2 hr. S/ 14 bo 63 bw 12 hr.
S/ 19 bo 85' bw 24 hr. PB 3931
24/ 3916-24 18/ 3888-3890 2 bw
PB 3755 24/ 3740-48

D & A

J. G. McGEHEE

Scout Cards	
Land Small Map	
Land Wall Map	
Tracings	
France Map	
Pierce Map	
Misc.	

May 6 1952

Orig. Date