


Section 21 Township 27 Range 11W

Well No. 1 Lion "A"

Company G-M-R Oil & Buffalo Oil

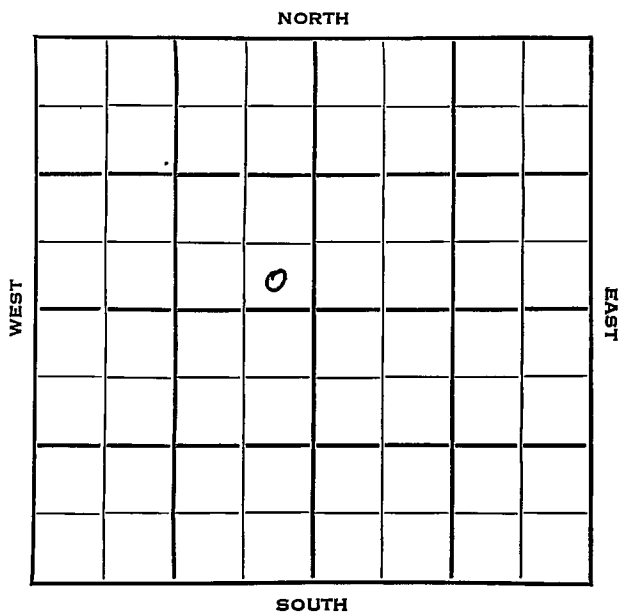

Pratt KANSAS


SEC.	TWP.	R.
21	27	11W ✓

WELL NO. 1 Lion "A" FARM

COMPANY G-M-R Oil & Buffalo Oil

CONTRACTOR G-M-R
Lion Pool

_____ Ft. from N. Line
330 _____ Ft. from S. Line
330 _____ Ft. from E. Line
_____ Ft. from W. Line

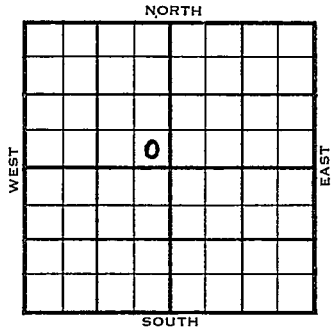

SE SE NW
Lion Farmout

1954	ELEVATION 1791'	REPORT
------	-----------------	--------

1/27 Spud 1-22-54
13" @ 180'
Drlg. 1401'

3/17 Spud 1-22-54 Oil well TD 4515
13" @ 180 Heeb 3421 Doug. 3493
DST 3500-52 open 1 hr rec 650' SW
1320# Br lime 3598 Lans 3617
DST 3773-3800, open 1 hr rec 1020' GCO
60' mud 1420#
DST 3822-35 open 1 hr rec 60' OCM, 90'
OCW 270' SW 1125#
Miss 4062
DST 4060-75 open 1 hr rec 40' mud
DST 4075-4105 open 1 hr rec 30' SOCM
O# Viola 4306'
DST 4310-22 open 1 hr rec 60' SO &
GCM 850#
DST 4323-32 open 1 hr rec 30' SO & GCM
Simp. 4394'
DST 4393-4427 open 1 hr rec 30' mud O#
Arb. 4481 TD 4515' 5" @ 4450
CO to 4372 24/4308-14 1/2 BO 30 min
500 A 1 BW & SO 1/2 hr. 40/4314-24
3 BWPB 12 hr. PB 4090 1/4071
1/4061 dry. PB 3975 33/3776-87

OVER

1954
3/17

(Information continued)

S/2 BWPH 10 GO 12/3796-99

S/2 BOPH 630 A F/18 BOPH 6 hr.

Comp. 355 BOPD

COMPLETED

JAN 28 1954

Street Cards	✓
Land Small Map	
Land Wall Map	✓
Tracings	
France Map	
Pierce Map	
Misc.	

Orig. Data

Great Carth MM
 Land Small Map _____
 Land Wall Map _____
 Tracings _____
 Plans Map _____
 Piece Map _____
 Misc. _____

23 1954
 1954 23

24/4308-14 1/2 bo 30 min. # 500
 1 bw & SO 1/2 hr. 40/4314 24-43 bwm
 12 hr. PB 409D 1/4071 34/4061 dry
 PB 3975 33/376-87 1 S/2 bwp # 101
 12/3796-99 S/2 bop 630
 Great Carth
 Comp. 6 hr. 18 bop

Dirg. Data