


Section 22 Township 27 Range 10W

Well No. #1 Richardson

Company Amerada

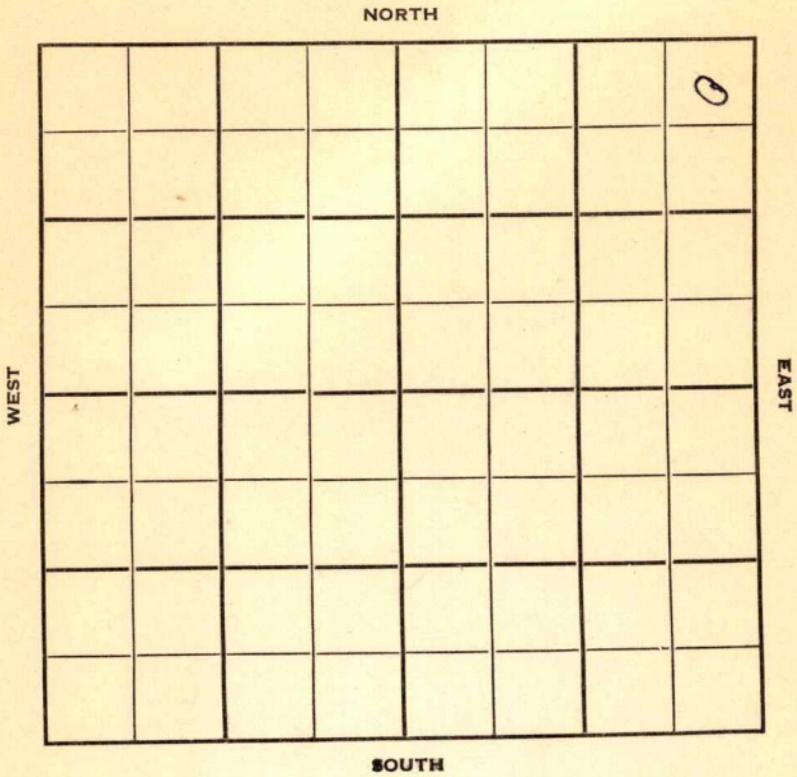



Sec. 22 Twp. 27 R. 10 W

Well No. # 1 Richardson Farm

Amerada Company

Contractor


330 Ft. from N. Line

Ft. from S. Line

330 Ft. from E. Line

Ft. from W. Line

NE NE NE

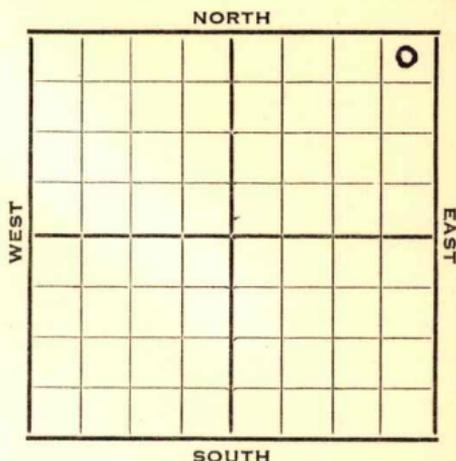

1952 Elev. 1748' REPORT

- 4/16 Location
- 4/23 9" @ 323 Drlg. 1300'
- 4/30 Drlg. 3440'
- 5/7 Topeka 2994 Br Li 3501
Lans. 3511
DST 3553-78 2 hrs. 65' WCM
700# Miss 4026
DST 4025-48 2 hrs. 2400' wtr 1275#
KH 4109 V 4313 RTD 4323
DD DST 4315-30 2 hrs. gas in 7"
est 200,000 cu ft gas unloaded to
sits 2400' oil 360' wtr 975# 15"
5" @
- 5/14 DST 4315-23, 2 hrs. 200,000 gas
2400' oil, 360' wtr. 975# TD 4323
7" @ 4323'
- 5/21 DP 4320' 8/ 4315-17 mud DP 4322
8/ 4319-21 3 gal m & wtr. DP 4323
8/ 4321-23 NS ? A 500
- 5/28 12/4321-23 wtr Hyd No help
DD 4324 TD S/200 BF 6 hr . 22% wtr
3,500,000 gas POP
- 6/11 205 Bfpd 6% wtr. 3% BS
- 6/18 NR

OVER

1952

6/25

Spd 4-19-52
Oil Well TD 4323
9" @ 323 Top 2994
Br Lime 3501 Lans. 3511
DST 3553-78 opn 2 hr.
Rec. 65' wcm Miss 4026
DST 4025-48 opn 2 hr. Rec. 2400'
wtr Kh 4109 Viola 4313
TD 4323 DST 4315-23 opn 2 hr.
gas in 7 min. est. 200,000 mcfg
2400' oil 360' wtr 7" @ 4323
DP 4320 8/4315-17 mud DP 4322
8/4319-21 3 gm & wtr DP 4323
8/4321-23 500 A S/5 bfph
12/4321-23 wtr Hydro DD 4324
S/200 bf 6 hr. 22% wtr.
Comp. 2359 bopd

COMPLETED

