


Section 22 Township 27 Range 35 W

Well No. # 1 English "D"

Company Columbian Fuel

NORTH

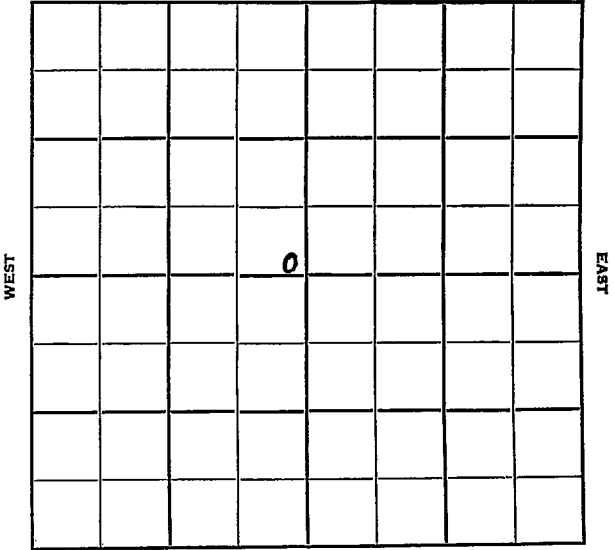

SOUTH

WEST

EAST

Grant

KANSAS

Sec. 22 Twp. 27 R. 35W

Well No. #1 English "D" Farm

Columbian Fuel Company

Contractor

Hugoton Pool


Ft. from N. Line

100' Ft. from S. Line

100' Ft. from E. Line

Ft. from W. Line

SE NW

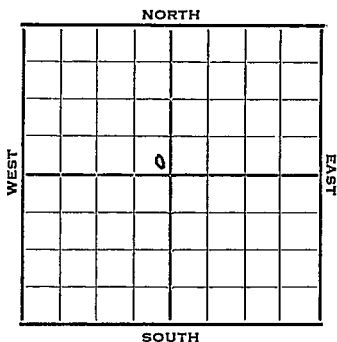

1952 Elev. 3075' REPORT

3/19 Drlg.  
 3/25 10" @ 560' RTD 2598'  
 6" @ 2590' WOCT  
 4/1 WOCT  
 4/9 "  
 4/23 "  
 4/30 DP 2785' TD 207' of 4" liner  
 15,000 A 17,470,000 gas RP 399  
 Hold for tops.  
 5/7 Spud 3-17-52  
 Gas Well TD 2785'  
 10" @ 560' 6" @ 2590 TD 2785'  
 Kri. 2620 Win. 2682  
 Ft. Riley 2727 15000 A  
 Comp. 17,470,000 gas

**COMPLETED**



