

Stanton


FORM 51 IOM 12-46 PETROL

KANSAS

Section 22 Township 27 Range 39W

Well No. 1 Congdon

Company Stanolind

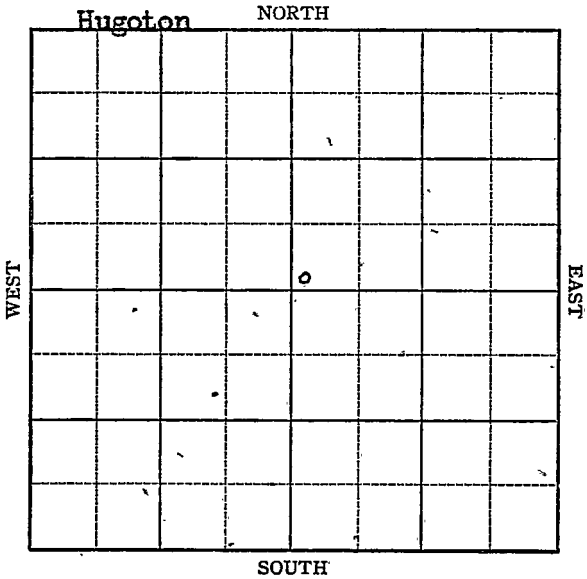

KANSAS

Sec. 22 Twp. 27 R. 39-W

Well No. #1 Congdon Farm
Stanolind Company
Hugoton Pool


 Ft. from N. Line

50 Ft. from S. Line

 Ft. from E. Line

50 Ft. from W. Line

SW NE

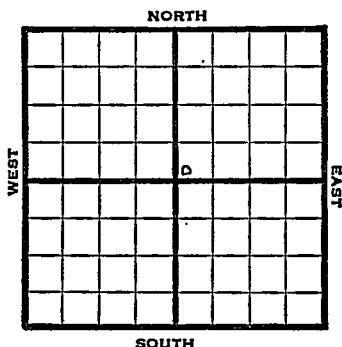

1947 Elev. 3177 REPORT

4/16 8" @ 705'
Drlg 1285'

4/23 TD 2518'
5" @ 2482'
RUST

4/30, 5" @ 482
Perf
13,500 Acid
5,245,000 Gas
345# R Pr
TD 2522'

COMPLETED

Map No. _____ Sec. 22 Twp. 27 R. 39W

Well No. 1 Congdon

Stanolind Company

FIRST REPORT Contractor _____

SW NE


SECTION PLAT

_____ Ft. from N. Line

50 Ft. from S. Line

_____ Ft. from E. Line

50 Ft. from W. Line

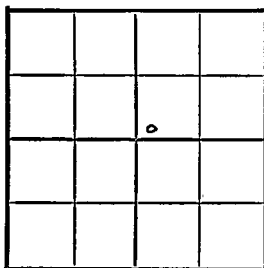

Stanton County

Location _____

Rig up _____

Drilling and Remarks:

8" @ 705

drlg. 1285

RECORD

Cased _____ in., _____ ft.

Sand _____

Gas _____

Oil _____

Total Depth _____

PRODUCTION

1st 24 hrs. Nat. _____

1st 24 hrs. after shot _____

Gas _____ Cu. Ft.

Dry Hole _____

Abandoned _____

Date

APR 16 1947 19 _____ S. J. LEWIS Scout

Map No. _____ Sec. 22 Twp. 27 R. 39W

Well No. 1 Congdon


Stanolind Company

COMPLETE

Contractor

SW NE

E 13177
SECTION PLAT

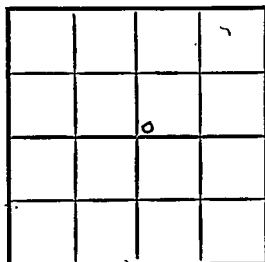

_____ Ft. from N. Line

50 Ft. from S. Line

_____ Ft. from E. Line

50 Ft. from W. Line

Stanton County

Location _____

Rig up _____

Drilling and Remarks: _____

5-202482

Perf.

1800000 oil

5,245,000 Gas

*345 * R/R*

RECORD

Cased _____ in., _____ ft.

Sand _____

Gas _____

Oil _____

Total Depth 2522

PRODUCTION

1st 24 hrs. Nat. _____

1st 24 hrs. after shot _____

Gas _____ Cu. Ft.

Dry Hole _____

Abandoned _____

Date

APR 30 1947 19

S. J. LEWIS Scout