

Section 22 Township 27 Range 5WWell No. #1 DieffenbacherCompany Bankoff Oil

NORTH

WEST

EAST

0							

SOUTH

Kingman

KANSAS

Sec. 22 Twp. 27 R. 5W

Well No. #1 Dieffenbacher Farm

Bankoff Oil Company

Smitherman - Contr. Contractor

Wildcat


 Ft. from N. Line

330' Ft. from S. Line

 Ft. from E. Line

330' Ft. from W. Line

SW SW SW

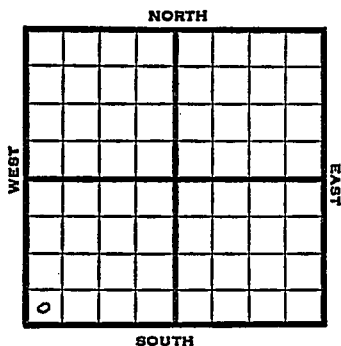

1951

Elev. 1491' REPORT

5/9

8" @ 154'

7/25

Oil Well TD 3819
8" @ 154 Top 2352
Heeb. 2690 Br Lime 2957
Lans. 2985 Miss ch 3762
Dol. 3803
DST 3804-18 opn 1 hr
Rec. 20' clean oil 220' hoem
TD 3818 5" @ 3802 DD 3819
F/10 boph Comp. F/28 bopd

COMPLETED

Operator Bankoff Oil

Well No. **1** Farm **Dieffenbacher**

Elev.	Location	SW	SW	SW
-------	----------	----	----	----

0

330 Ft. From S Line SW

330 Ft. From **W** Line Quarter

1st. Report MAY 9 1951

Completion

Remarks	Texas	DHM
---------	-------	-----


Smitherman - Contr.

Spudding Date _____

Drig. Data Wildcat

8th @ 154

County Kineman State Kansas
 Sec. 22 (Blk.) 27 (Sur.) 5W Map No.
 Operator Bankoff Oil
 Well No. 1 Farm Dieffenbacker
 Elev. 1491 Location SWSW SW

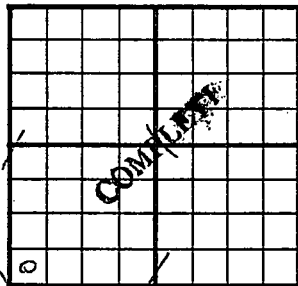

330 Ft. From S Line SW
330 Ft. From W Line Quarter
 1st. Report
 Completion JUL 25 1951
 Remarks Wildcat
Smitherman - Contr.
 Spudding Date

Drlg. Data Oil well TD 3819
8" @ 154 Top. 2352 Heeb. 2690
Br. lime 2957 Lans. 2985 Miss. ch. 3762
Dol. 3803 DST 3804-18 open 1 hr.
Rec. 20' clean oil 220' hocr TD 3818
5" @ 3802 DD 3819 F/ 10 bopd
Comp. F/ 28 bopd

J. E. TYRA