


Section 22 Township 27 Range 5W

Well No. #2 Dieffenbacher

Company Bonkoff

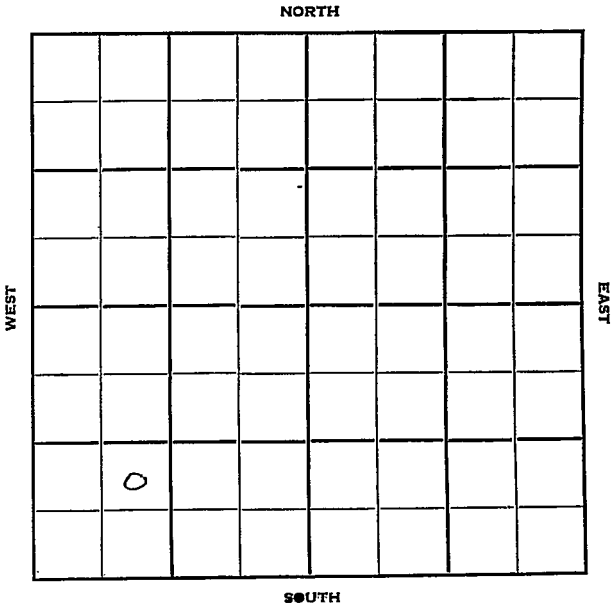

Sec. 22 Twp. 27 R. 5W

Well No. #2 Dieffenbocher Farm

Bonkoff Company

Contractor

_____ Ft. from N. Line

990'


_____ Ft. from S. Line

_____ Ft. from E. Line

990'

_____ Ft. from W. Line

NE SW SW

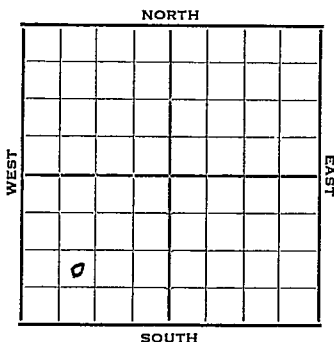

1952

Elev. 1491' REPORT

2/6

Spud 1-30-52
8" @ 160
Drlg. 1840'

2/13

KC 2983' Drlg. 3218'

2/20

Miss Chat 3778 Miss li 3804
Miss Dol 3811 TD 3840
5" @ 3840'

3/5

12/3807-09 test wtr 6/3805-06
Test wtr & SSO 6/3819-21 No-Inc.
20/3821-26 Set pkr 3817
1000 A Sq off perfs CO to 3835

3/12

Spud 1-30-52
D & A TD 3845' 8" @ 160
KC 2983' Miss chat 3778' Miss
lime 3804' Miss dol. 3811'
TD 3845' 5" @ 3845'
DST 3804-20 open 1 hr. rec 240' O & GCSW
760' O & GCSW CO to 3830'
12/3807-09 water 6/3805-06 water
6/3819-21 10/3821-26 SP 3817
1000 A CO to 3835'
D & A

ABANDONED

