

KANSAS

Form 51-5M-4-36-Palace


~~SUMMIT~~

Sedgwick

Section 22 Township 27 Range 3-W

Well Number #1-Schere (*Scheer*)

Company R. J. Wallace et al

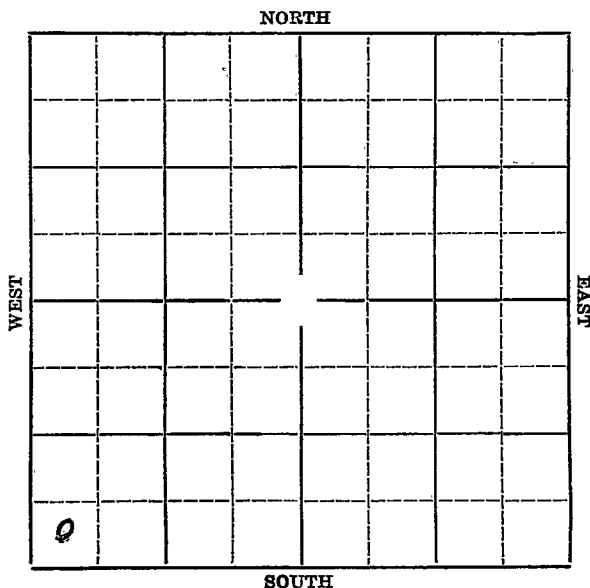

Sedgwick

Map No. KANSAS Sec. 22 Twp. 27 R. 3W

Well No. #1 Schere Farm

J.F. Wallace et al Company


 Ft. from N. Line

330' Ft. from S. Line

 Ft. from E. Line

330' Ft. from W. Line

Elev. 1463

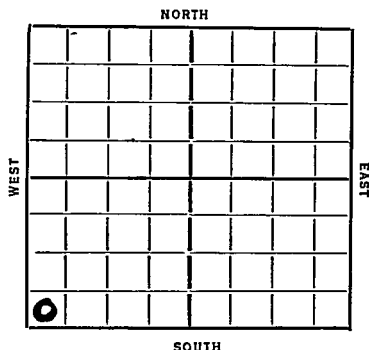

Date 1936

REPORT

8/12 Rig.
8/20 12" @ 135'. TD 185'. WOC.
8/27 Drlg. 1210'.
9/3 Drlg. 2180'.
9/10 Topeka 2180'. Show oil Lansing.
2779'. Drilling 3075'.
9/18 3215' fishing.
9/24--
10/1 Plug back to 3016'.
10/8--
10/15 Clean out.
10/22 Drlg. 3200'.
10/29 Chat 3690'. Drlg. 3743'.
11/6 3936 Fishing
11/12 Drlg. 3975
11/19 Viola 4162'. T. D. 4165
Fishing.
11/27 Sil. 4270'. Water. 4285'.
Plugging back.

OVER

1936

12/3 6" @ 4110'. WOC.

12/10--Shut down.

12/16 Sil. 4270'. T. D. 4285'.
Water.

ABANDONED

KANSAS

Map No. 38 Sec. 22 Twp. 27 R. 3WWell No. 1 SchererR. J. Wallace & Son Company

Contractor

SECTION PLAT

 Ft. from N. Line330 Ft. from S. Line Ft. from E. Line330 Ft. from W. Line

FIRST REPORT

Location Rig up

Drilling and Remarks:

Rig

RECORD

Cased in., ft.Sand Gas Oil Total Depth

PRODUCTION

1st 24 hrs. Nat. 1st 24 hrs. after shot Gas Cu. Ft.Dry Hole Abandoned

Date

JUN 22 1936 19S. J. LEWIS Scout

Returned.....
Cards.....
Tracing.....
France Map.....
Scarborough Map.....
Moody Map.....
Scarborough Plat Book.....
Moody Plat Book.....

KANSAS

Map No. 38 Sec. 22 Twp. 27 R. 3W.Well No. 1 SchorrR. J. Wallace & Son Company

Contractor

SECTION PLAT

0			

 Ft. from N. Line330 Ft. from S. Line Ft. from E. Line830 Ft. from W. Line

ABANDONED

Location Rig up

Drilling and Remarks:

5164270waterIVH

RECORD

Cased in., ft.Sand Gas Oil Total Depth 4285

PRODUCTION

1st 24 hrs. Nat. 1st 24 hrs. after shot Gas Cu. Ft.Dry Hole Abandoned

Date

DEC 16 1926 19

S. J. LEWIS Scout

Returned.....

Cards.....

Tracing.....

France Map.....

Scarborough Map.....

Muddy Map.....

Scarborough Fire Book.....

Muddy Fire Book.....