


Sedgwick

KANSAS

SECTION 22 TOWNSHIP 27 RANGE 4W

WELL NO. #1 Rosenhagen

COMPANY Cities Service

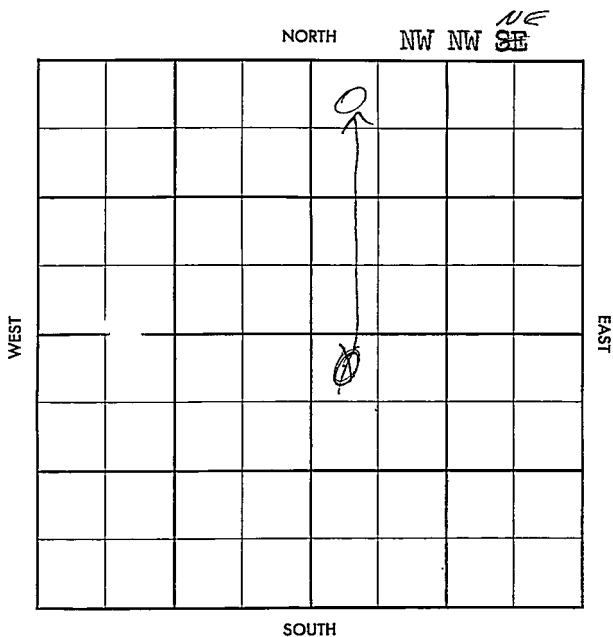

WILDCAT

FORM 513 SUNRAY

County Seeger Elev.
 Sec. 22 Twp. 27 Rge. LW
 Company Cities Service
 Farm Name Rosenhagen No. 1

TOPS	DEPTH	LOG	DATUM	Loc. in Sec.
Anh.				NW NW SE
Tr.				
H.				
Tr.				
Dg.				
BL.				
L.				Geol.
K.C.				Contr.
B.K.C.				
Ce.				
C.				
M.				
M.				Pool
K.				Wildcat
Mz.				
Ma.				
V.				
S.				
S.				
A.				
R.				
Pe.				
G.				
T.D.				

0
MAR 20 '57

Date Comm. 3-15-57
8" @ 203/150 WOR

22

CORRECTION

FORM 513 SUNRAY

County Sedgewick Elev. 1474 Co. 1
 Sec. 22 Twp. 27 Rgs. 6W
 Company Cities Service
 Farm Name Rosenhaven

TOPS	DEPTH	LOG	DATUM	Loc in Sec.
Anb.				NE
TP.	2292			
H. <u>orlad</u>	2549			
Tr. <u>H6</u>	2642			
Dg.				
BL.	2879			
L.	2907			
K.C.				Geol.
B.K.C.				Contr.
Ce.				
C.				
M. <u>Chert</u>	2721			
M. <u>61</u>	3776			
K. <u>Miss Polo</u>	3795			
Mz.				
Mo.				
V.	4223			
S. <u>5d</u>	4241			
S.				
A.	4352			
R.				
PE.				
G.				
TD.	4372			

ABANDONED

Date Comm. 3-15-57
 8" @ 203/150 WOP 27 57 ✓
2583 APR 10 '57 3753 APR 12 '57
 DST 3755 - 3804 1hr. 40' ME'SW
 BHP 525/20 DST 3849-65 1hr.
 1093' ME'SW BHP 1365/30"
 DST 4222-34 90" 3' Md BHP
 0 4245 APR 24 '57 DST 4234-46
 80" 530' ME'SW BHP 2030/20
DEAR