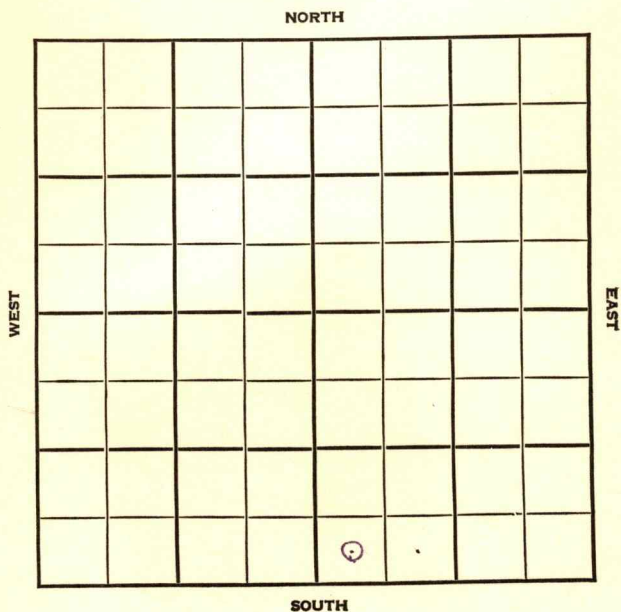


Section 19 Township 27 Range 23-WWell No. #1 DavisCompany Texas

Ford
27

23W

Sec. 19 Twp. R.

Well No. #1 Davis Farm

Texas

Company

Wildcat


Ft. from N. Line

330' Ft. from S. Line

Ft. from E. Line

330' Ft. from W. Line

SW SE

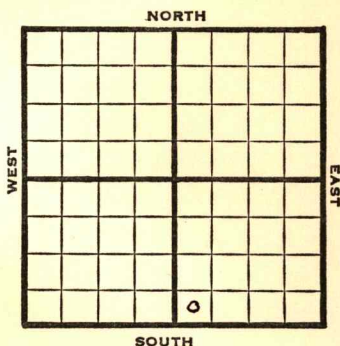

1948

Eli 2477'

REPORT

6/16	Derriek	
6/23	RUR	
7/1	Drilling 1370'	(Tel)
6/29	13"@ 313'	
	Drlg 1370'	
7/8	9"@ 1536'	
	Drlg 2820'	
7/14	F& Riely 2798'	
	Drlg 3885'	
7/21	B Americans 3360'	
	Heebner 4184'	
	Lansing 4304'	
	Drlg 4352'	
7/28	Drlg 4868'	
8/4	Mississippi 4994'	
	Drlg. 5268'	
8/11	Warsaw 5280'	
	Drlg 5658'	
8/18	Viola 5682'	
	impson 5808'?	
	Drlg 5972'	
8/25	Arb. 5894'	
	TD 6058'	
	Aband.	
	ABANDONED	

Map No. _____ Sec. 19 Twp. 27 R. 23WWell No. 1 DavisTexas

Company _____

FIRST REPORT

Contractor _____


SW SE

SECTION PLAT

_____ Ft. from N. Line

330 Ft. from S. Line

_____ Ft. from E. Line

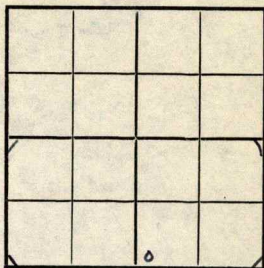330 Ft. from W. LineFord County

Location _____

Rig up _____

Drilling and Remarks:

Derrick

RECORD

Cased _____ in., _____ ft.

Sand _____

Gas _____

Oil _____

Total Depth _____

PRODUCTION

1st 24 hrs. Nat. _____

1st 24 hrs. after shot _____

Gas _____ Cu. Ft.

Dry Hole _____

Abandoned _____

Date

JUN 16 194819S. J. LEWISScout

