


Section 21 Township 27 Range 23W

Well No. #1 Dinkela

Company I. W. Wiegel et al

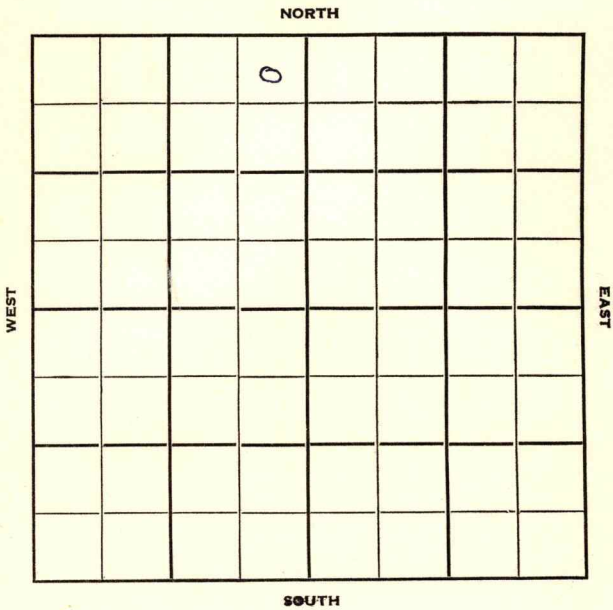

Sec. 21 Twp. 27 R. 23W

Well No. #1 Dinkela Farm

I. W. Siegel, et al Company

Mid-American - Contr. Contractor
Wildcat


330' Ft. from N. Line

Ft. from S. Line


330' Ft. from E. Line

Ft. from W. Line

NE NE NW

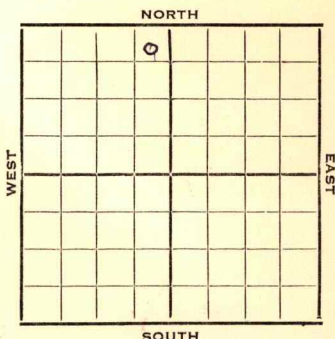

1952	Elev. 2405' REPORT
5/28	Spud 5-26-52 8" @ 240 WOC
6/11	DST 3855-75, 1 hr. 410' SW 1120# Drlg. 4125'
6/18	Topeka 3771' Heeb 4141' Lans. 4274' Drlg. 4946'
6/25	Spud 5-26-52 D&A T 5100 8" @ 240 DST 3855-75 opn 1 hr. Rec. 410' sw Top 3771 Heeb. 4141 Lans. 4274 DST 2677-2700 opn 1 hr. Rec. 84' sw BKC 4702 TD 5100 D&A ABANDONED

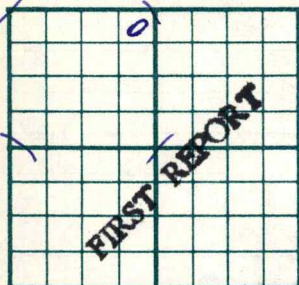County Ford State KansasSec. 21 (Blk. Twp.) 27 (Sur. Rge.) 23W Map No.Operator I. W. Siegel et al.Well No. 1 Farm DinkelaElev. _____ Location NE NE NW330 Ft. From N Line NW330 Ft. From E Line Quarter1st. Report MAY 28 1952

Completion _____


Remarks _____

Mid-American - Contr.Spudding Date 5-26-52

Drlg. Data _____

Wildcat8" @ 240 WOC

J. G. McGEHEE

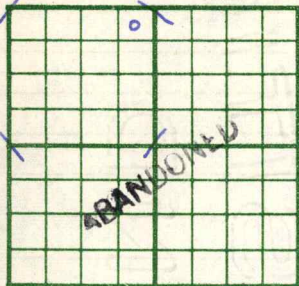County Ford State KansasSec. 21 (Blk. 27 (Sur. 23W Map No. (Twp.) (Rge.)Operator I. W. Siegel et al.Well No. 1 Farm DinkelaElev. 2405 Location NE NE NW330 Ft. From N Line NW330 Ft. From E Line Quarter

1st. Report

Completion JUN 25 1952Remarks WildcatMid-American - Contr.Spudding Date 5-26-52Drlg. Data D & A TD 51008" @ 240 DST 3855-75 open 1 hr.Rec. 410' sw Top. 3771 Heeb. 4141Lans. 4274 DST 2677-2700 open 1 hr.Rec. 84' sw B KC 4702 TD 5100D & A

J. G. McGEHEE