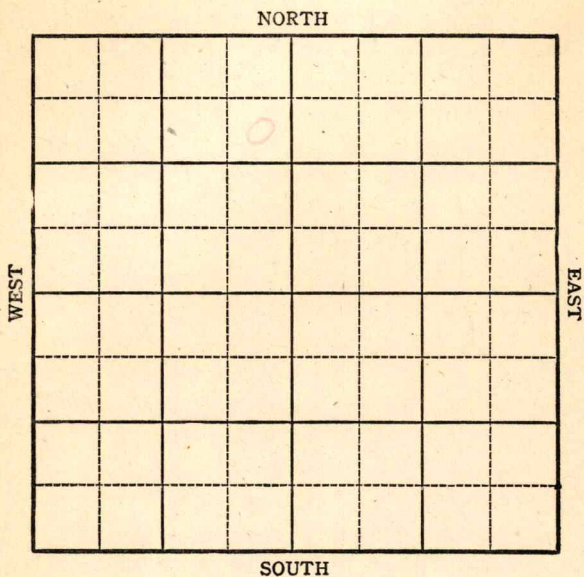


KANSAS

Ford County

Section 33 Township 27 Range 23WWell No. #1 ThomasCompany Texas

KANSAS

Ford County

Sec. 33 Twp. 27 R. 23W

Well No. #1 Thomas Farm

Texas

Company


Wildcat

990 Ft. from N. Line

Ft. from S. Line

330 Ft. from E. Line

Ft. from W. Line

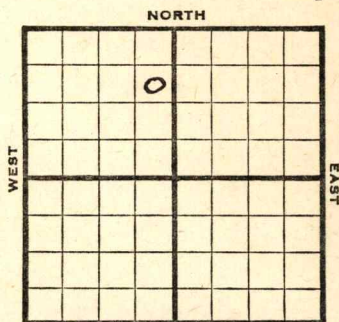

SE NE NW *Elev. 2459*

1944

R E P O R T

10/4	Location
10/11	Drk.
10/18	13" @ 201
	Drlg. 800
10/25	Drlg. 2360
11/1	3282 fsg.
11/8	Drlg. 3704
11/16	Drlg. 4445'
11/24	4954 Drlg.
11/29	Drlg. 5228
12/6	Miss 5120
	Drlg. 5554'
12/14	5700 fsg.
12/21	Drlg. 5748'
12/29	Drlg. 6020'
1945	
1/3	Miss 5043 Misener 5720
	Viola 5722 SS0 5722-27 5837-47
	TD 6152 in arb
1/10	Simp 5847 SO 5850-58
	5884-89 5904-09
	Arb 5917 SO 5919-26 TD 6162
	5 @ 6054 Rust
1/17	5 shots 5917-21 3500' w in 3/4 hr
	Plug back to 5912

OVER

1945

1/26 Plug 5858
5 shots 5850-5856 1100' water
Plug 5845

1/31 Arb. 5917
5" @ 6054
TD 6162

ABANDONED

Pool Name Wildcat
 Map No. 89 **KANSAS** Sec. 33 Twp. 27 R. 23W
 Well No. 1 Thomas

Texas

Company

FIRST REPORT

Contractor

SE NE NW

SECTION PLAT

990

Ft. from N. Line


Ft. from S. Line

330

Ft. from E. Line

Ft. from W. Line

Ford

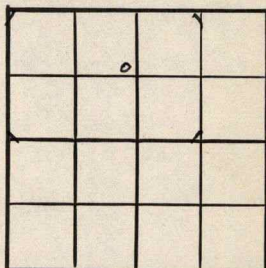

Location X

Rig up

Drilling and Remarks:

RECORD

Cased in., ft.

Sand

Gas

Oil

Total Depth

PRODUCTION

1st 24 hrs. Nat.

1st 24 hrs. after shot

Gas Cu. Ft.

Dry Hole

Abandoned

Date

OCT 4 1944 19

S. J. LEWIS Scout

Pool Name WildcatMap No. 189 Sec. 33 Twp. 27 R. 23WWell No. 1 ThomasTexas

Company

ABANDONED

Contractor

SE NE NW

SECTION PLAT

	o		

990 Ft. from N. Line

Ft. from S. Line

330 Ft. from E. Line

Ft. from W. Line

Ford County

Location

Rig up

Drilling and Remarks:

Ar X 5917
5" C 6054

RECORD

Cased _____ in., _____ ft.

Sand _____

Gas _____

Oil _____

Total Depth 6162

PRODUCTION

1st 24 hrs. Nat. _____

1st 24 hrs. after shot _____

Gas _____ Cu. Ft.

Dry Hole _____

Abandoned _____

Date

JAN 31 1945

19

S. J. LEWIS

Scout