

KANSAS

Grant

23

Section ~~11~~ Township 27 Range 37W


Well No. 1 Hill Unit

Company Magnolia Pet. Co.

NORTH

WEST

EAST

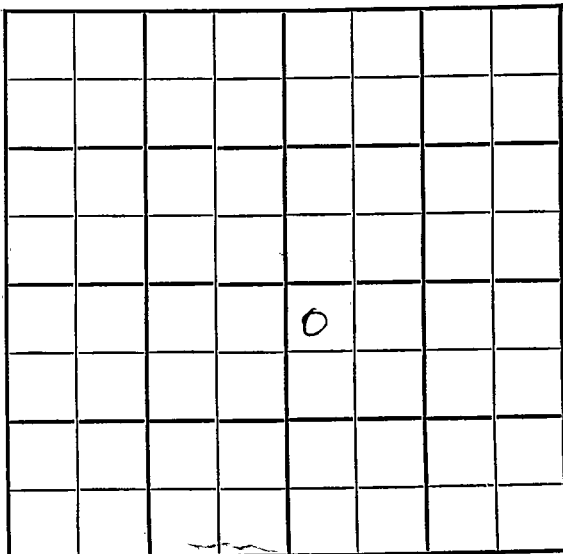

SOUTH

Sec. 14 23 Twp. 27 R. 37W

Well No. #1 Hill Unit Farm
Magnolia Company
Hugoton


330 Ft. from N. Line

_____ Ft. from S. Line

_____ Ft. from E. Line

330 Ft. from W. Line

NW SE

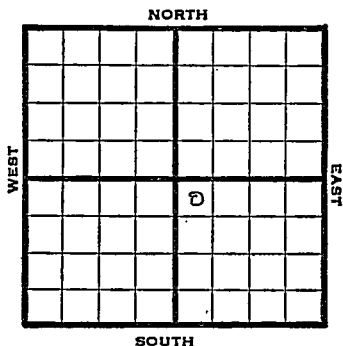

~~1948~~

Elev. 3030' REPORT

4/28

10" @ 684'

5/5

TD 2714'
7" @ 2711'
RUST

5/12

167 shots 2528-64' - 7000 acid.

5/19

96 shots 2482-2504 7000 acid
96 " 2424-46 " "

6/1

7" @ 2711'
Perf.
Acid 28,000
Gas 7,918,000
R. Pr. 390#
TD 2714'

COMPLETED

Map No. _____ Sec. 14 Twp. 27 R. 37W

Well No. 1 Hill Unit

Magnolia Company

FIRST REPORT Contractor

NW SE

SECTION PLAT

330 Ft. from N. Line

_____ Ft. from S. Line

_____ Ft. from E. Line

330 Ft. from W. Line

| | | | |
|--|--|---|--|
| | | | |
| | | | |
| | | o | |
| | | | |

Grant County

Location _____

Rig up _____

Drilling and Remarks:

10" @ 684

RECORD

Cased _____ in., _____ ft.

Sand _____

Gas _____

Oil _____

Total Depth _____

PRODUCTION

1st 24 hrs. Nat. _____

1st 24 hrs. after shot _____

Gas _____ Cu. Ft.

Dry Hole _____

Abandoned _____

Date

APR 28 1948

19

S. J. LEWIS

Scout

Map No. _____ Sec. 23 Twp. 27 R. 37W

Well No. 1 Hill Unit

Magnolia Company

CORRECTION Contractor

NW SE

SECTION PLAT

330 Ft. from N. Line

_____ Ft. from S. Line

_____ Ft. from E. Line

330 Ft. from W. Line

| | | | |
|--|--|---|--|
| | | | |
| | | | |
| | | o | |
| | | | |

Grant County

Location _____

Rig up _____

Drilling and Remarks:

Reported

14-27-37W

RECORD

Cased _____ in., _____ ft.

Sand _____

Gas _____

Oil _____

Total Depth _____

PRODUCTION

1st 24 hrs. Nat. _____

1st 24 hrs. after shot _____

Gas _____ Cu. Ft.

Dry Hole _____

Abandoned _____

Date

MAY 12 1948

19

S. J. LEWIS Scout

Map No. _____ Sec. 23 Twp. 27 R. 37W

Well No. 1 Hill Unit

Magnolia Company

COMPLETE

Contractor

NW SE

E13030
SECTION PLAT

330 Ft. from N. Line

_____ Ft. from S. Line

_____ Ft. from E. Line

330 Ft. from W. Line

| | | | |
|--|--|--|--|
| | | | |
| | | | |
| | | | |
| | | | |
| | | | |

Grant County

Location _____

Rig up _____

Drilling and Remarks:

7" @ 2711

Prof.

28000 acid

7, 918, 000 Gas

390 # R/A

RECORD

Cased _____ in., _____ ft.

Sand _____

Gas _____

Oil _____

Total Depth 2714

PRODUCTION

1st 24 hrs. Nat. _____

1st 24 hrs. after shot _____

Gas _____ Cu. Ft.

Dry Hole _____

Abandoned _____

Date

JUN 1 1948 19

S. J. LEWIS

Scout