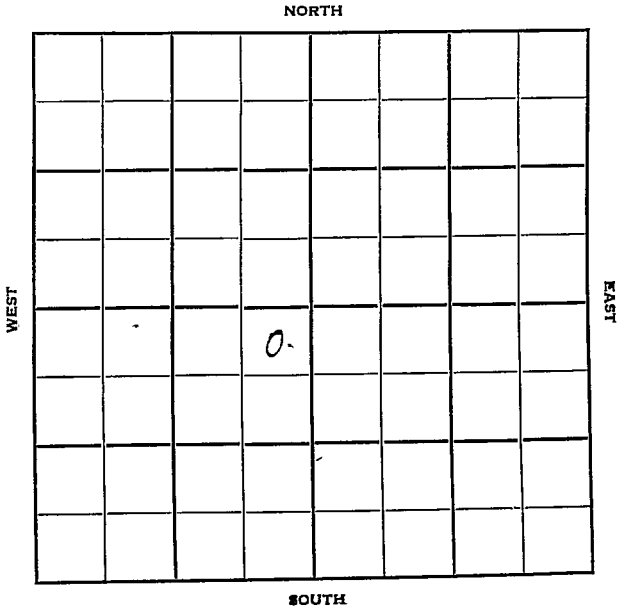


FORM 51 25M 3-49 PETROL

Section 23 Township 27 Range 35WWell No. #1 D. A. Askew "A"Company Columbian Fuel

Sec. 23 Twp. 27 R. 35-W

Well No. #1 D A Askew "A" Farm

Columbian Fuel Company

Contractor

Hugoton Pool


330 Ft. from N. Line

         Ft. from S. Line

330 Ft. from E. Line

         Ft. from W. Line

NE NE SW

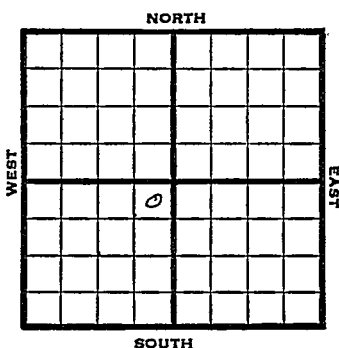

1950

Elev 3060

REPORT

3/22 Location

5/24 10" @ 600

7" @ 2598

TD 2608

DD 2810

228' of 5" limer

Hev 2599

Winfield 2682

Ft Riley 2724

15,000 acid

Comp 18,176,000 gas

Completed

**COMPLETED**

Map No. \_\_\_\_\_ Sec. 23 Twp. 27 R. 35WWell No. 1 D. A. Askew "A"\_\_\_\_\_ Columbian Fuel \_\_\_\_\_ Company

\_\_\_\_\_ Contractor

NE NE SW


## SECTION PLAT

330 Ft. from N. Line

\_\_\_\_\_ Ft. from S. Line

330 Ft. from E. Line

\_\_\_\_\_ Ft. from W. Line

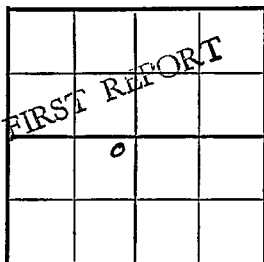Grant CountyLocation X

Rig up \_\_\_\_\_

Drilling and Remarks:

## RECORD

Cased \_\_\_\_\_ in., \_\_\_\_\_ ft.

Sand \_\_\_\_\_

Gas \_\_\_\_\_

Oil \_\_\_\_\_

Total Depth \_\_\_\_\_

## PRODUCTION

1st 24 hrs. Nat. \_\_\_\_\_

1st 24 hrs. after shot \_\_\_\_\_

Gas \_\_\_\_\_ Cu. Ft.

Dry Hole \_\_\_\_\_

Abandoned \_\_\_\_\_

Date

MAR 22 1950 19J. E. TYRA Scout


Kansas

Map No. \_\_\_\_\_ Sec. 23 Twp. 27 R. 35WWell No. 1 D. A. Askew "A"Columbian Fuel Company\_\_\_\_\_  
Contractor

NE NE SW

E1.3060

SECTION PLAT

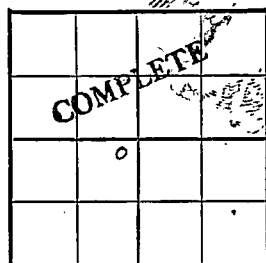\_\_\_\_\_  
Ft. from N. Line330 Ft. from S. Line\_\_\_\_\_  
Ft. from E. Line330 Ft. from W. LineGrant

Location \_\_\_\_\_

Rig up \_\_\_\_\_

Drilling and Remarks:

10" C 600  
 7" C 2598  
 T.D. 2608  
 DD 2810  
 228' of 5" liner

## RECORD

Cased \_\_\_\_\_ in., \_\_\_\_\_ ft.

Sand \_\_\_\_\_

Gas \_\_\_\_\_

Oil \_\_\_\_\_

Total Depth \_\_\_\_\_

## PRODUCTION

1st 24 hrs. Nat. \_\_\_\_\_

1st 24 hrs. after shot \_\_\_\_\_

Gas \_\_\_\_\_ Cu. Ft.

Dry Hole \_\_\_\_\_

Abandoned \_\_\_\_\_

Date

MAY 24 1944J. E. TYRA Scout