


Section 23 Township 27 Range 10W

Well No. #1 Wingen

Company United Prod.

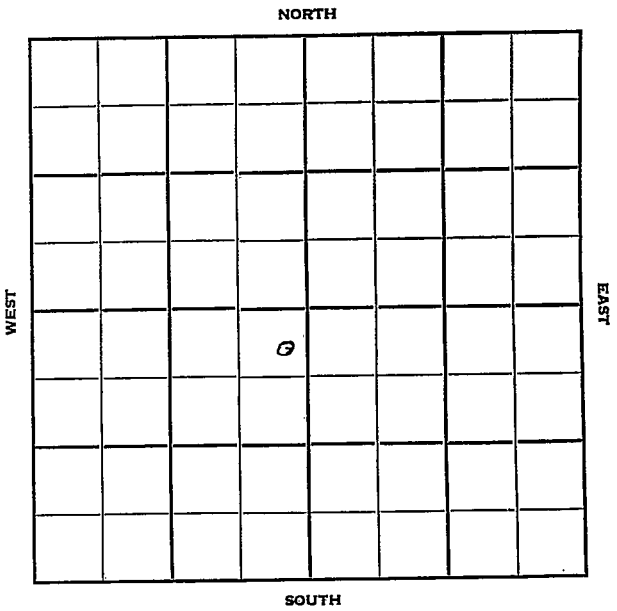

Stanton

KANSAS

Sec. 23 Twp. 27 R. 40 W

Well No. # 1 Wingen Farm

United Prod. Company

Contractor

Hugoton Pool


350 Ft. from N. Line

Ft. from S. Line

150 Ft. from E. Line

Ft. from W. Line

NE SW

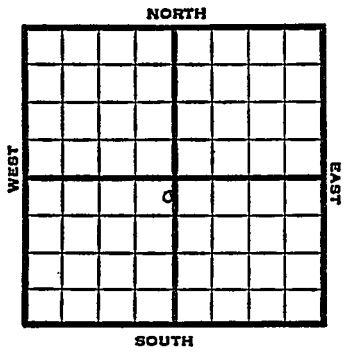

1951 Elev. 3221' REPORT

8/29 Spud 8-26-51
10" @ 421' WOC

10/3 Spud 8-26-51
Gas well TD 2366' 10" @ 421'
7" @ 2230' TD 2366' Her. 2226'
Kri. 2237' Win. 2278' Ft. Riley
2348' 25,000 A
Comp. 19,700,000 gas.

COMPLETED

County Stanton State Kansas

Sec. 23 (Blk. Twp.) 27 (Sur. Rge.) 4 ~~OF~~ Map No.

Operator United Prod.

Well No. I Farm Wingen.

Elev. _____ Location NE SW

FIRST REPORT								
						0		

350 Ft. From N Line SW

150 Ft. From E Line Quarter

1st. Report AUG 29 1951

Completion _____

Remarks _____

Spudding Date 8-26-51

Drlg. Data Hugoton Pool

10" @ 421 WOC.

