


Pratt

Section 24 Township 27 Range 11-W

Well No. #5 Krehbiel "A"

Company Skelly

Cunningham Pool

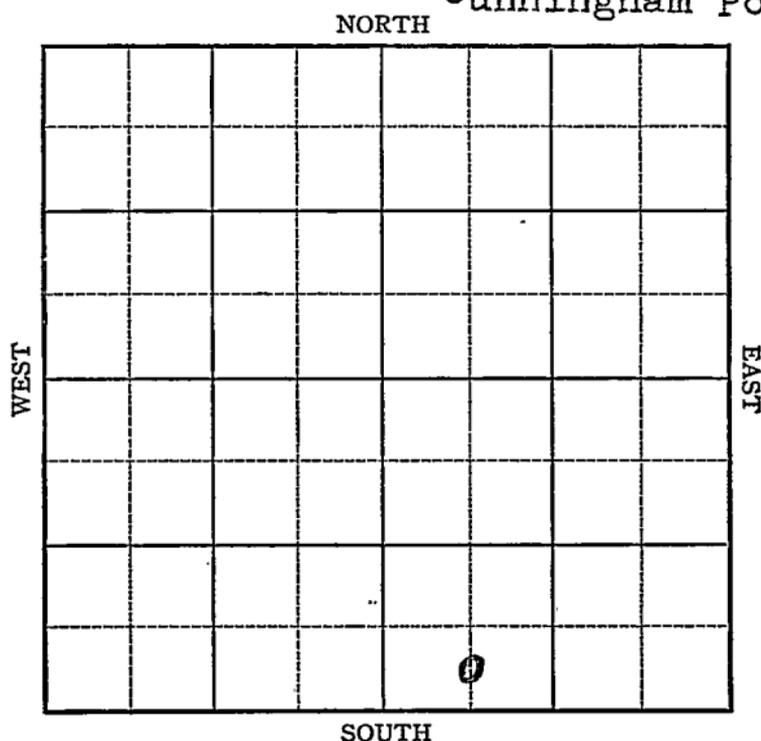



Map No. 54 Sec. 24 Twp. 27 R. 11WWell No. 5 Krehbiel "A"Skelly Company

Contractor

**FIRST REPORT**

C S L SW SE

         Ft. from N. Line330 Ft. from S. Line         Ft. from E. Line660 Ft. from W. Line

CUNNINGHAM POOL

**SECTION PLAT**


Location XRig up         

Drilling and Remarks:

**RECORD**Cased          in.,          ft.Sand         Gas         Oil         Total Depth         **PRODUCTION**1st 24 hrs. Nat.         1st 24 hrs. after shot         Gas          Cu. Ft.Dry Hole         Abandoned         

Date

APR 16 1941 19 S. J. LEWIS Scout

Map No. 54 Sec. 24 Twp. 27 R. 11WWell No. 5 Krebbiel "A"

Skelly Oil

Company

Contractor

~~COMPLETED~~

## SECTION PLAT

C S L SW SE

\_\_\_\_\_ Ft. from N. Line

330 Ft. from S. Line

\_\_\_\_\_ Ft. from E. Line

660 Ft. from W. Line

CUNNINGHAM POOL

	.		

Location \_\_\_\_\_

Rig-up \_\_\_\_\_

Drilling and Remarks:

*Leas 3455*  
*5" @ 3456 1/2*  
*7000 acw/c*  
*Pump 335 P & Y*  
  
*345 G*

## RECORD

Cased \_\_\_\_\_ in., \_\_\_\_\_ ft.

Sand \_\_\_\_\_

Gas \_\_\_\_\_

Oil \_\_\_\_\_

Total Depth 3519

## PRODUCTION

1st 24 hrs. Nat. \_\_\_\_\_

1st 24 hrs. after shot \_\_\_\_\_

Gas \_\_\_\_\_ Cu. Ft.

Dry Hole \_\_\_\_\_

Abandoned \_\_\_\_\_

Date

MAY 21 1941<sub>19</sub>

S. J. LEWIS Scout