

KANSAS

Pratt


FORM 51 5M 4-41 PETROL

Section 24 Township 27 Range 11-W

Well No. #6 Krehbiel "A"

Company Skelly Oil

NORTH Cunningham Pool

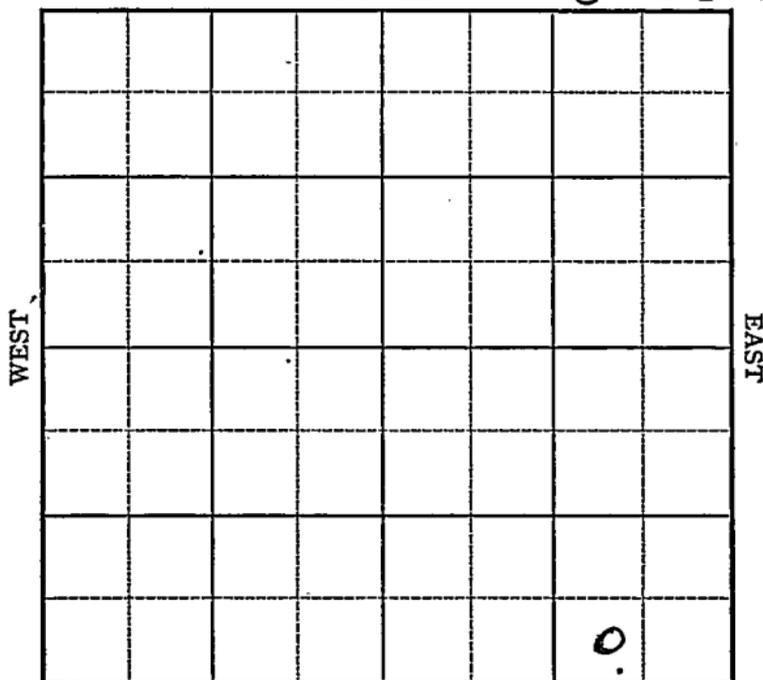


SOUTH

Sec. 24 Twp. 27 R. 11-WWell No. #6 Krehbiel "A" FarmSkelly Oil Company

(Cunningham)

         Ft. from N. Line330 Ft. from S. Line669 Ft. from E. Line         Ft. from W. Line

Elev. 1748

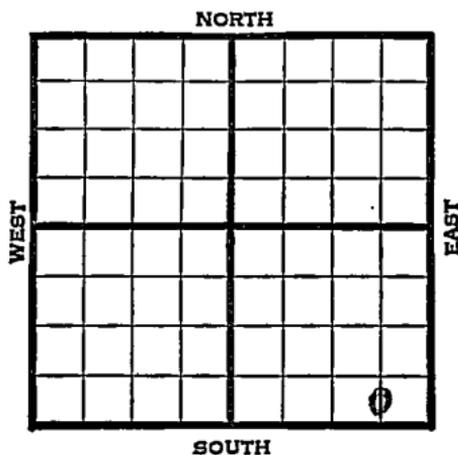

1941

REPORT

5/7

Location

5/15

"

5/22

Derrick.

5/28

10" - 369' Drlg. 1375'

6/5

Drlg. 3246'

6/12

Lans. 3460' 5" - 3463'

T.D. 3474' RUST.

6/18

Lans. 3460'

5" - 3463'

T.D. 3510'

7000 acid.

Potential 445 bbls., pump.

34.5 Gravity

COMPLETED

Map No. 54 Sec. 24 Twp. 27 R. 11W

Well No. 6 Krehbiel "A"

Skelly Oil

Company

FIRST REPORT

Contractor

**SECTION PLAT**

**C S L SE SE**

         Ft. from N. Line

330 Ft. from S. Line

669 Ft. from E. Line

         Ft. from W. Line

**CUNNINGHAM POOL**


Location X

Rig up         

Drilling and Remarks:

**RECORD**

Cased          in.,          ft.

Sand         

Gas         

Oil         

Total Depth         

**PRODUCTION**

1st 24 hrs. Nat.         

1st 24 hrs. after shot         

Gas          Cu. Ft.

Dry Hole         

Abandoned         

Date

MAY 7 1941 19

S. J. LEWIS Scout

Map No. 54 Sec. 24 Twp. 27 R. 11WWell No. 6 Krehbiel "A"Skelly Oil

Company

Contractor

**COMPLETED**

C S L SE SE

\_\_\_\_\_ Ft. from N. Line

330 Ft. from S. Line669 Ft. from E. Line

\_\_\_\_\_ Ft. from W. Line

## SECTION PLAT


CUNNINGHAM POOL

Location \_\_\_\_\_

Rig up \_\_\_\_\_

Drilling and Remarks:

*Lease 3460**5" C 3463**7000 acd**Pump 445 RY**345 G*

## RECORD

Cased \_\_\_\_\_ in., \_\_\_\_\_ ft.

Sand \_\_\_\_\_

Gas \_\_\_\_\_

Oil \_\_\_\_\_

Total Depth 3570

## PRODUCTION

1st 24 hrs. Nat. \_\_\_\_\_

1st 24 hrs. after shot \_\_\_\_\_

Gas \_\_\_\_\_ Cu. Ft.

Dry Hole \_\_\_\_\_

Abandoned \_\_\_\_\_

Date

JUN 18 1941

19

S. J. LEWIS Scout