

# KANSAS

Pratt


FORM 51 5M 4-41 PETROL

Section 24 Township 27 Range 11-W

Well No. #1 North Maxedon

Company Skelly Oil

Cunningham Pool

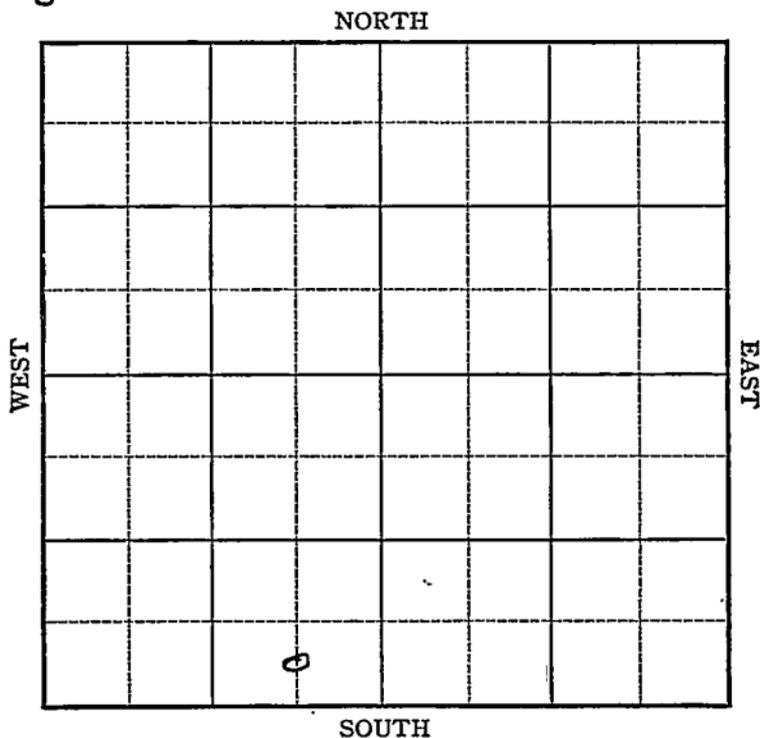

Sec. 24 Twp. 27 R. 11-W

Well No. #1 North Maxedon Farm

Skelly Oil Company  
(Cunningham)


         Ft. from N. Line

330' Ft. from S. Line

660' Ft. from E. Line

         Ft. from W. Line

Elev. 1707

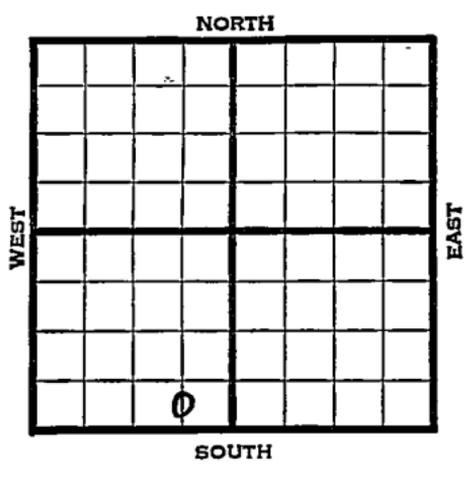

REPORT	
1947	
7/30	Derrick
8/7	10" @ 360' Drlg. 1800'
8/15	Dl.g 3400'
8/21	Lans. 3453' 5" - 3456'
	T.D. 3459' 500' water 3 hours.
8/28	Drlg. 3605' 2250' water.
9/4	T.D. 3633' 345' of 4" liner at 3622' WOC.
9/11	" " "
9/18	T.D. 3678' SD. 10,000 gas.
9/25	" " " " "
10/2	Drlg. 3700'
10/9	T.D. 3701' P.B. to 3626' Shut down.
10/16	" "
10/23	" "
	<b>OVER</b>

1941  
10/29

Lans. 3453'  
5" - 3456'  
T.D. 3678'  
Water.

**ABANDONED**

Map No. 54 Sec. 24 Twp. 27 R. 11WWell No. 1 North MaxedonSkelly Oil

Company

Contractor

## FIRST REPORT

C S L SE SW

Ft. from N. Line

330 Ft. from S. Line660 Ft. from E. Line

Ft. from W. Line

CUNNINGHAM POOL

## SECTION PLAT


Location \_\_\_\_\_

Rig up \_\_\_\_\_

Drilling and Remarks:  
Derrick

## RÉCORD

Cased \_\_\_\_\_ in., \_\_\_\_\_ ft.

Sand \_\_\_\_\_

Gas \_\_\_\_\_

Oil \_\_\_\_\_

Total Depth \_\_\_\_\_

## PRODUCTION

1st 24 hrs. Nat. \_\_\_\_\_

1st 24 hrs. after shot \_\_\_\_\_

Gas \_\_\_\_\_ Cu. Ft.

Dry Hole \_\_\_\_\_

Abandoned \_\_\_\_\_

Date

JUL 30 1941

19

S. J. LEWIS Scout

Misc Small Maps	PAV
Cards	PAV
Tracing	PAV
France Map	PAV
Scarborough Map	PAV
Moody Map	
Geological Dept.	
Moody Plat Book	



Misc. Small Maps	<i>DM</i>
Cards	<i>DM</i>
Tracing	<i>DM</i>
France Map	<i>DM</i>
Scarborough Map	<i>DM</i>
Moody Map	<i>DM</i>
Geological Dept.	
Moody Plat Book	