

KANSAS

Form 51-5M-7-40-Palace


Pratt

Section 24 Township 27 Range 11-W

Well No. #1 Steffen

Company Spring Rose

NORTH Cunningham Pool

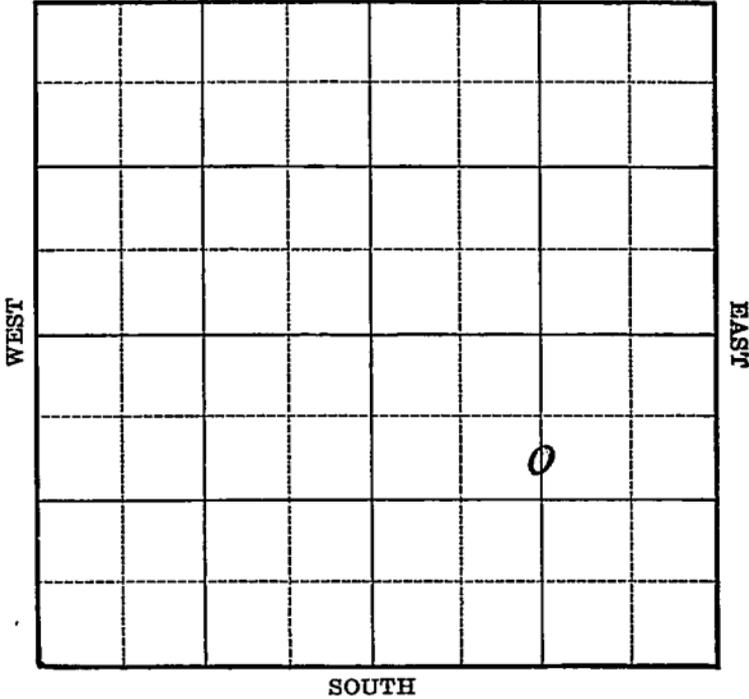

Sec. 24 Twp. 27 R. 11-WWell No. #1 Steffen FarmSpring Rose Company

(Cunningham)


990 Ft. from N. Line

_____ Ft. from S. Line

1320 Ft. from E. Line

_____ Ft. from W. Line

Elev. 1719

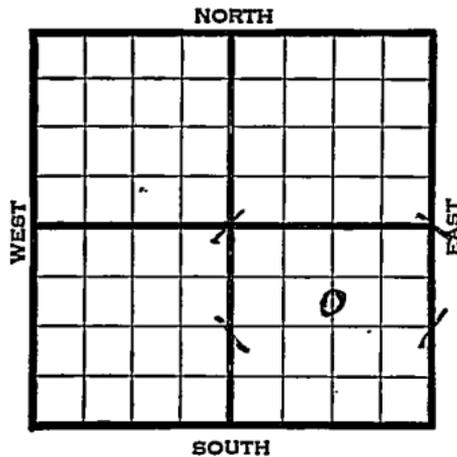

1940.	REPORT
10/9	Drlg. 260'
10/17	15" - 137' 10" - 450'
	Drlg. 1150'
10/24	Drlg. 2010'
10/31	Viola 4128' 5" - 4129' RUST.
11/7	Drlg. 4144'
11/14	Show gas 4135' HFW 4144'
	P.B. 4100'
11/21	P.B. 3550' 43 shots 3518-40' SS
	400' fluid 60 hrs, 50% oil.
11/27	5000 acid. 2000' fluid.
12/5	" " " "
12/12	" " " "
12/19	" " " "
12/23	Viola 4128'
	5" - 4129'
	T.D. 4144'
	H.F.W.
	ABANDONED

Map No. 54 Sec. 24 Twp. 27 R. 11W

Well No. 1 Steffen

Spring Rose

Company

Contractor

FIRST REPORT

C S L N $\frac{1}{2}$ SE

990 Ft. from N. Line


_____ Ft. from S. Line

1320 Ft. from E. Line

_____ Ft. from W. Line

CUNNINGHAM POOL

SECTION PLAT

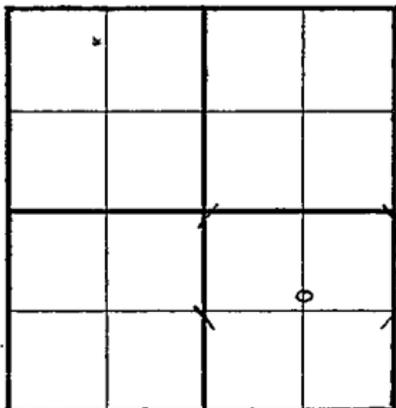

Location _____

Rig up _____

Drilling and Remarks:
Drlg. 260

RECORD

Cased _____ in., _____ ft.

Sand _____

Gas _____

Oil _____

Total Depth _____

PRODUCTION

1st 24 hrs. Nat. _____

1st 24 hrs. after shot _____

Gas _____ Cu. Ft.

Dry Hole _____

Abandoned _____

Date

OCT 9 1940 19

S. J. LEWIS Scout

Map No. 54 Sec. 24 Twp. 27 R. 11WWell No. 1 SteffenSpring Rose

Company

Contractor

ABANDONED

SECTION PLAT

C S L N $\frac{1}{2}$ SE990 Ft. from N. Line

_____ Ft. from S. Line

1320 Ft. from E. Line

_____ Ft. from W. Line

CUNNINGHAM POOL

Location _____

Rig up _____

Drilling and Remarks:

*Vista 4128.**5" C 4129.**NFW.*

RECORD

Cased _____ in., _____ ft.

Sand _____

Gas _____

Oil _____

Total Depth 4144

PRODUCTION

1st 24 hrs. Nat. _____

1st 24 hrs. after shot _____

Gas _____ Cu. Ft.

Dry Hole _____

Abandoned _____

Date

DEC 23 1940 19

S. J. LEWIS Scout