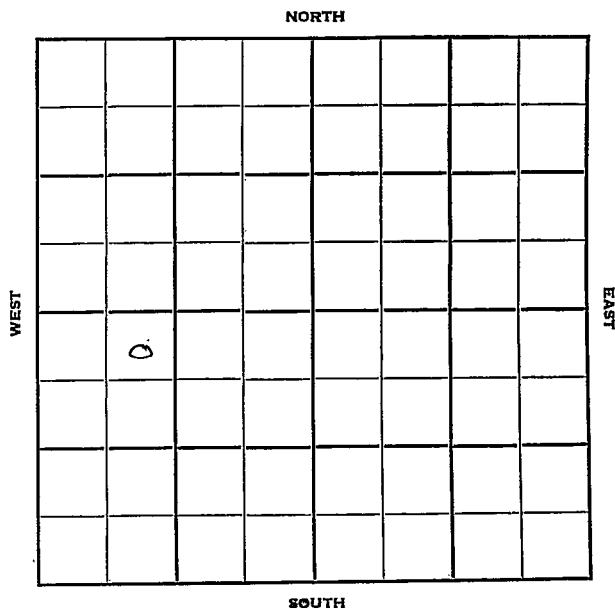


Section 25 Township 27 Range 12WWell No. #3 BarnesCompany Hamilton Bros.

Sec. 25 Twp. 27 R. 12W

Well No. #3 Barnes Farm

Hamilton Bros.

Company

Anschultz

Contractor


330 Ft. from N. Line

Ft. from S. Line

Ft. from E. Line

990 Ft. from W. Line

NE NW SW

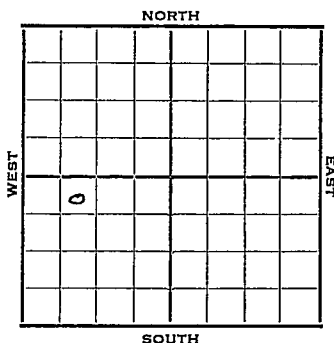

1952 Elev. 1757' REPORT


- 4/2 Spud 3-16-52
13" @ 110' 8" @ 810
Br L 3580 Lans. 3600
DST 3712-40 1 hr. 240' muddy SW
1200# Miss 4055
DST 4055-65 $\frac{1}{2}$ hr. 30' M 0#
DST 4065-85, 1 hr. 30' M
0# Drlg. 4132'
- 4/9 V 4240 DST 4244-68, 1 hr. gas in 5"
115' GCM Est 2 to 4 M 1345#
Simp sd 4331 DST 4344-40, $\frac{1}{2}$ hr.
6' m 0# DST 4335-40, 1 hr. 1530
GCW 1290# Arb. 4439 RTD 4445
5" @ 3940 Sch.
- 4/23 48/4302-14 500 A 16/4284-88 NS
16/4276-80 NS 16/4262-66 NS
16/4252-56 NS 24/4249-56 500 A
Est 2 to 3 M gas 64/4239-48
500 A Est 400,000
- 4/30 2500 A 1 M gas.
- 5/7 NR
- 5/13 Spud 3-16-52 D&A TD 4445'
13" @ 110 8" @ 810'
Br Li 3580 Lans. 3600
DST 3712-40, open 1 hr. rec. 240'
muddy SW Miss. 4055

OVER

1952

5/13 DST 4055-65' open $\frac{1}{2}$ hr. rec. 30' mud
DST 4065-85 open 1 hr. rec. 30' mud
Viola 4240
DST 4244-68 open 1 hr. rec. 115' GCM
Simp. 4331 DST 4334-40 open $\frac{1}{2}$ hr.
Rec. 6' mud DST 4335-50 open 1 hr.
rec. 1530' GCW Arb. 4439
TD 4445' 5" @ 4326' 48/ 4302-14
500 A 16/ 4284-88 16/ 4276-80
16/ 4262-66 16/ 4252-56 24/ 4249-56
500 A 2 to 3 mcf/g 64/ 4239-48
500 A 400,000 gas 250 A
100,000 gas D&A

ABANDONED

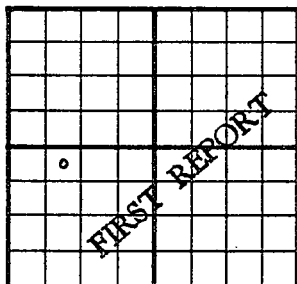County Pratt State KansasSec. 25 (Blk. Twp.) 27 (Sur. Rge.) 12W Map No.Operator Hamilton Bros.Well No. 3 Farm BarnesElev. 1757 Location NE NW SW330 Ft. From N Line SW990 Ft. From W Line Quarter1st. Report APR 2 1952

Completion _____

Remarks _____

Anschultz - Contr.Spudding Date 3-16-52

Drlg. Data _____


13" @ 110 8" @ 810 BrL 3580 Lens 3600DST 3712-40 1 hr. 240' muddy SW 1200#Miss 4055 DST 4055-65 $\frac{1}{2}$ hr. 30' M 0#DST 4065-85 1 hr. 30' M 0# Drlg. 4132J. G. McGEHEE

Scout Cards *12*
Land Small Map
Land Wall Map *3*
Tracings
France Map
Pierce Map
Misc.

APR 4 1952

Orig. Data

County Pratt State Kansas
 Sec. 25 (Bk. 27 (Sur. 12W Map No.
 (Twp.) (Rge.)
 Operator Hamilton Bros.
 Well No. 3 Farm Barnes
 Elev. 1757 Location NE NW SW

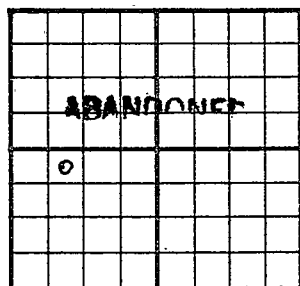

330 Ft. From N Line SW
990 Ft. From W Line Quarter

1st. Report

Completion MAY 14 1952

Remarks

Anschultz - Contr.

Spudding Date 3-16-52

Drlg. Data D & A TD 4445

13" @ 110 8" @ 810 Br. lime 3580

Lans. 3600 DST 3712-40 open 1 hr.

Rec. 240' muddy sw Miss. 4055 DST 4055-

65 open $\frac{1}{2}$ hr. Rec. 30' mud

DST 4065-85 open 1 hr. Rec. 30' mud

Viola 4240 DST 4244-68 open 1 hr.

Rec. 115' gcm Simp. sd. 4331

DST 4334-40 open $\frac{1}{2}$ hr. Rec. 6' mud

DST 4335-50 open 1 hr. Rec. 1530' gcw

Arb. 4439 TD 4445 5" @ 4326 48/ 4302-

14 500 A 16/ 4284-88 16/ 4276-80

16/ 4262-66 16/ 4252-56 24/ 4249-56

500 A 2 to 3 mofg 64/ 4239-48 500 A

J. G. McGEHEE

Scout Cards

Land Small Map

Land Wall Map

Tracings

France Map

Pierce Map

Misc.

D. & A.

400,000 gas 250 A 100,000 gas

MAY 21 1952

Drig. Data