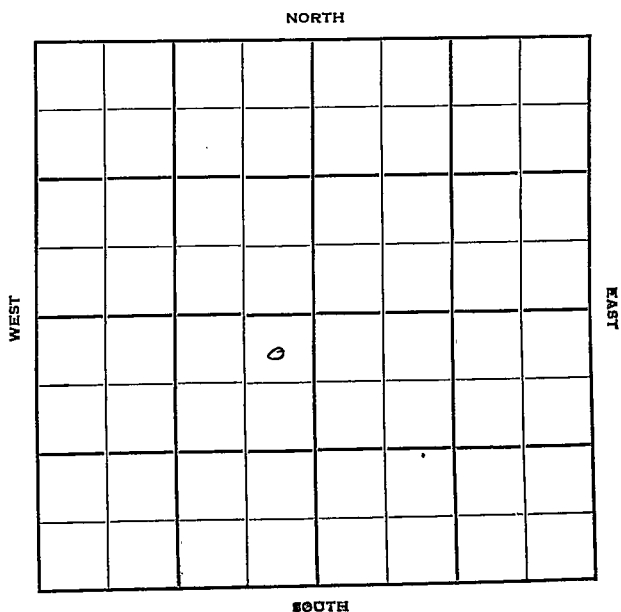


Section 25 Township 27 Range 12WWell No. #1 BarnesCompany Anchultz

Pratt

KANSAS

Sec. 25 Twp. 27 R. 12W

Well No. #1 Barnes Farm

Anchultz Company

Wildcat


330' Ft. from N. Line

 Ft. from S. Line

330' Ft. from E. Line

 Ft. from W. Line

NE NE SW

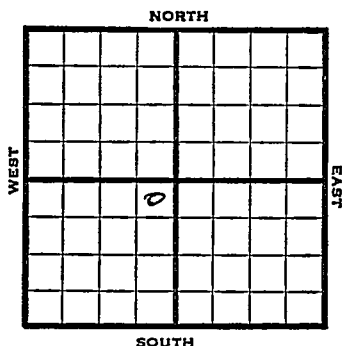

1951

Elev. 1751' REPORT

10/17

Location

1952

1/30

Spud 11-9-51 Gas Well TD 4430
8" @ 372 Doug 3466 Lans. 3608
DST 3788-3802 opn 1 $\frac{1}{4}$ hr. Rec. 312' gcm
& oil Miss 4001
DST 4001-18 opn 1 hr. Rec. 407' oil
DST 4034-50 opn 1 hr. Rec. 55' gcm
DST 4050-78 opn 1 hr. Rec. 35' g&ocm
Viola 4229
DST 4230-45 opn 45 min. gas in 16
min Rec. 33' gcm tr. oil
DST 4245-60 opn 45 min. gas in 15
min. Rec. 60' hgcm Simp sh 4302
Dol. 4305 Sand 4324
DST 4310-48 opn 15 min. gas in 3 min.
Rec. 2,530,000 gas Rec. 330' hgcm
70' sw DST 4348-63 opn $\frac{1}{2}$ hr.
Rec. 7' mud Arb. 4421
DST 4421-30 opn $\frac{1}{2}$ hr Rec. 371' sul.
wtr TD 4430 5" @ 4430 PB 4100
19/4068-74 19/4060-66 PB 4056
19/4043-53 500 A $\frac{1}{2}$ mcfg 10 goph
PB 4020 24/4004-12 $\frac{1}{4}$ mcfg 500 A
Hydra S/l bo oil dec. SP 3826
25/3793-3801 2 mcfg 3000 A PB 3821
24/3796-3802 24/3793-99 3000 A
S/3 boph 50% wtr CO to 3910

OVER

1952 (Information brought forward)

1/30 35/3882-88 $\frac{1}{4}$ mcfg 33/3886-92
no inc. B/5 boph SP 3860
2000 A S/7 bf $\frac{3}{4}$ mcfg 3 hr.
F/ $1\frac{1}{2}$ bo 1 hr. dec. to 0
est. 1 mcfg CO to 3910
Dp to 4100 SP 3990
Corrected Tops:
Miss 4031 Kh. 4167
Simp sh 4322 Sd 4325
Arb. 4420 CO to 4356
48/4346-54 PB 4340
45/4328-36
 $\frac{1}{4}$ mcfg 1000 A Est. 500,000
gas inc. to 15 mcfg.
Comp. 7,868,000 gas

COMPLETED


J. E. TYRA

Scout Cards	
Land Small Map	
Land Wall Map	
Tracings	3
France Map	
Pierce Map	
Misc.	

19 1951

Orig. Data

County Pratt State Kansas
 Sec. 25 (Blk. 27) (Sur. 12W) Map No. 1
 Operator Anschutz Drlg.
 Well No. 1 Farm Barnes
 Elev. 1751 Location NE NE SW

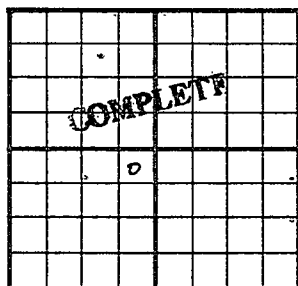

330 Ft. From N Line SW
330 Ft. From E Line Quarter
 1st. Report
 Completion JAN 30 1952
 Remarks Wildcat
D & M Drlg. - Contr.
 Spudding Date 11-9-51

Drlg. Data Gas well TD 4430
8" @ 372 Doug. 3466 Lans. 3608
DST 3788-3802 open 1 1/2 hr. Rec. 312' gcm
& oil Miss. 4001 DST 4001-18 open 1 hr
Rec. 407' oil DST 4034-50 open 1 hr.
Rec. 55' gcm DST 4050-78 open 1 hr.
Rec. 35' g & ocm Viola 4229
DST 4230-45 open 45 min. gas in 16 min.
Rec. 33' gcm tr. oil DST 4245-60
open 45 min. gas in 15 min. Rec. 60'
hgcm Simp. sh. 4302 Dot. 4305
Sand 4324 DST 4310-48 open 15 min.
Gas in 3 min. Rec. 2,530,000 gas
Rec. 330' hgcm 70' sw DST 4348-63
open 1/2 hr. Rec. 7' mud Arb. 4421

J. G. McGEHEE

Drig. Data

DST 4421-30 open $\frac{2}{3}$ hr. Rec. 371' su1.

water TD 4430 5" @ 4430 PB 4100

19/ 4068-74 19/ 4060-66 PB 4056

19/ 4043-53 500 A $\frac{2}{3}$ mcf 10 goph

PB 4020 25/ 4004-12 $\frac{1}{4}$ mcf 500 A

Hydro. S/ 1 bo oil dec. SP 3826

25/ 3793-3801 2 mcf 3000 A PB 3821

24/ 3796-3802 24/ 3793-99 3000 A

S/ 3 boph 50% water CO to 3910

35/ 3882-88 $\frac{1}{4}$ mcf 33/ 3886-92

no inc. B/ 5 goph SP 3860 2000 A

S/ 7 bf $\frac{3}{4}$ mcf 3 hr. F/ $1\frac{1}{2}$ bo 1 hr.

dec. to 0 est. 1 mcf CO to 3910

DP to 4100 SP 3990

CORRECTED TOPS

Miss. 4031 Km. 4167 Simp. sh. 4322

Sd. 4325 Arb. 4420 CO to 4356

48/ 4346-54 PB 4340 45/ 4328-36

$\frac{1}{2}$ mcf 1000 A est. 500,000 gas

inc. to 15 mcf

Comp. 7,868,000 gas

Misc.

Pierce Map

France Map

Tracings

Land Wall Map

Land Small Map

Scout Cards

1956

9