


FORM 51 25M 3-49 PETROL Pratt

Section 25 Township 27 Range 12W

Well No. #4 Barnes

Company Hamilton Bros.

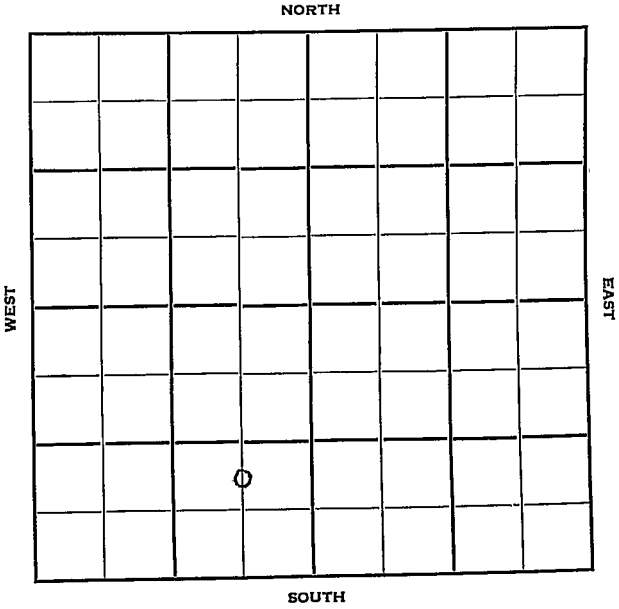

Sec. 25 Twp. 27 R. 12W

Well No. #4 Barnes Farm

Hamilton Bros. Company

Contractor


Ft. from N. Line

990 Ft. from S. Line

660 Ft. from E. Line

Ft. from W. Line

SW 1/4 C N L SE SW

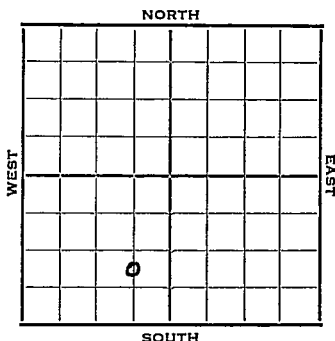

1952 Elev. 1732' REPORT

10/22 Spud 10-11-52  
13" @ 135'  
8" @ 815'  
Anhy 750'  
Drlg. 3486'

10/29 Br li 3560, Lans 3578  
DST 3515-30, 1 hr., 90' hly gcm 300' oil  
DST 3782-3800, 1 hr., 90' gcm  
DST 4029-39, 1 hr., 20' md  
230#  
V 4236', Simp sd 4335  
DST 4355-60

11/5 DST 4355-60, 1 hr., 20' M  
RTD 4385, Schl  
5" @ 3835 CO

11/12 CO 3808' 44/3620-32 500 A  
B/1/4 BO plus 3/4 BWPB

11/19 Spud 10-11-52  
D&A  
TD 4385'  
13" @ 135'  
8" @ 815'  
Anhy 750, Br. lime 3560, Lans 3578  
DST 3615-30, opn 1 hr., rec. 90' hgcm, 300' oil,

OVER

(Information Brought Forward)

1952  
11/19

DS<sup>T</sup> 3782-3800, opn 1 hr., rec.  
90' gcm,  
DST 4029-39, opn 1 hr., rec.  
20' mud, 230#  
Viola 4236, Simp. 4335,  
DST 4352-67, opn 1 hr., r ec.  
20' mud,  
TD 4385  
5" @ 3835,  
CO to 3808  
44/3620-32, 500A  
B/  $\frac{1}{4}$  bo 3/4 bwph  
D&A

**ABANDONED**

County Pratt State Kansas

Sec. 25 (Blk.) 27 (Sur. Rge.) 12W Map No.

Operator Hamilton Bros.

Well No. 4 Farm Barnes

Elev. Location C N L SE SW


990 Ft. From S Line SW

660 Ft. From E Line Quarter

Ist. Report OCT 22 1952

Completion \_\_\_\_\_

Remarks \_\_\_\_\_

Spudding Date 10-11-52

Drlg. Data \_\_\_\_\_

13" @ 135 8" @ 815 Anhy 750

drlg. 3486

Scout Cards	AD
Land Small Map	
Land Wall Map	B
Tracings	
France Map	
Pierce Map	
Blank	

OCT 27 1952

Orig. Data

County Pratt State Kansas

Sec. 25 (Blk. 27) (Sur. 12W) (Rge.) Map No.

Operator Hamilton Bros.

Well No. 4 Farm Barnes

Elev. 1732 Location C N L SE SW


990 Ft. From S Line SW

660 Ft. From E Line Quarter

1st. Report

Completion NOV 19 1952

Remarks

Spudding Date 10-11-52

Drlg. Data D & A TD 4385

13" @ 135 8" @ 815 Anhy 750

Br. lime 3560 Lans. 3578 DST 3615-30

open 1 hr. Rec. 90' hgcm 300' oil

DST 3782-3800 open 1 hr. Rec. 90' gcm

DST 4029-39 open 1 hr. Rec. 20' mud

230# Viola 4236 Simp. 4335

DST 4352-67 open 1 hr. Rec. 20' mud

TD 4385 5" @ 3835 CO to 3808

44/ 3620-32 500 A B/ 1/2 bo 3/4 hwph

D & A

J. G. MCGEHEE

Scout Cards	10
Land Small Map	
Land Wall Map	32
Tracings	
France Map	
Pierce Map	
Misc.	

NOV 25 1992

Drig. Data