

Pratt

KANSAS

Section 25 Township 27 Range 12 W

Well No. # 1 Barnes Est.

Company Lion Oil

NORTH

				0			

WEST

EAST

SOUTH

Pratt

KANSAS

Sec. 25 Twp. 27 R. 12W

Well No. #1 Barnes Est Farm

Lion Oil Company

Rine - Contr. Contractor


Ft. from N. Line

330' Ft. from S. Line

Ft. from E. Line

330' Ft. from W. Line

SW SW NE

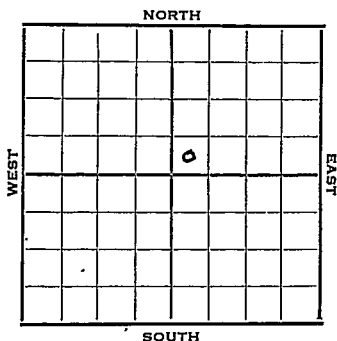

1951 Elev. 1755' REPORT

12/19 Spud 12-18-51
Drlg.

1952
1/23 Spud 12-18-51
D&A TD 4456 8" @ 338
Br Li 3578 Lans. 3599
DST 3654-3702 open 1 hr. rec. 270'
gassy wtr. DST 3706-13 open 45 min.
rec. 36' mud. DST 3724-35 open 1 hr.
rec. 110' GCM & wtr. DST 3764-93
open 1 hr. rec. 465' gas 146' GOCM
40 mud & wtr. DST 3830-18 open 1 hr.
rec. 30' ocm 1230' gas 120' wtr.
DST 3902-08 open 1/2 hr. rec. 3534' gas
144' mud & oil 83' wtr. DST 4021-33
open 1/2 hr. rec. 30' mud Miss. 4051
DST 4062-74 open 1 hr. rec. 10' mud
DST 4036-4101 open 1 1/2 hr. rec. 45' mud
DST 4248-76 open 1 hr. rec. 93' GCM
Simp. 4321 DST 4323-57 open 1 hr.
rec. 330' mud & wtr. TD 4456
17/ 4394-4400 24/ 4367-75 wtr.
PB 4350 46/ 4330-38 SSO 2000 A
B/ 1 BWPH PB 4326 24/ 4312-20
wtr. PB 4296 23/ 4279-87 wtr.
SP 4271 60/ 4256-70 1000 A 1/2 MCFG
2 BWPH PB 4085 24/ 4069-77 SSO
1000 A Test dry. PB 3885 22/ 3869-77

OVER

1952

1/23 SSO 1000 A S/ 20 BW 16 BOPD
DP to 4085 PB 3920 16/ 3902-06
S/ 20 BW 16 BOPD PB 3850 22/
3830-38 wtr. PB 3822 11/ 3813-17
wtr. PB 3800 23/ 3787-95 wtr.
PB 3780 24/ 3770-78 wtr. PB 3765
24/ 3751-59 wtr. PB 3742 22/ 3725-
33 wtr. PB 3720 12/ 3716-20 wtr.
12/ 3707-11 wtr. PB 3702 23/ 3692-
3700 wtr. PB 3670 12/ 3656-60
wtr. PB 3650 23/ 3633-41
D&A

ABANDONED


County Pratt State Kansas

Sec. 25 (Blk. Twp.) 27 (Sur. Rge.) 12W Map No.

Operator Lion Oil

Well No. 1 Farm Barnes est

Elev. Location SW SW NE

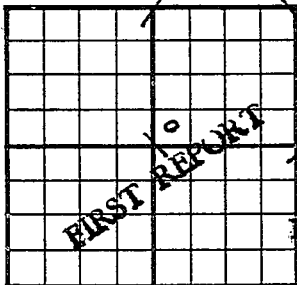

330 Ft. From S Line NE

330 Ft. From W Line Quarter

1st. Report DEC 1 9 1951

Completion

Remarks

Rine - Contr.

Spudding Date 12-18-51

Drig. Data

Drig.

J. E. TYRA

Scout Cards	116
Land Small Map	
Land Wall Map	
Tracings	
France Map	
Pine Map	
MISC.	

Drig. Date

Simp. 4321 DST 4323-57 open 1 hr.

Rec. 330' mud & water TD 4456

17/4394-4400 24/4367-75 water

PB 4350 46/4330-38 SSO 2000 A

R/1 bwpn PB 4326 24/4312-20

water PB 4296 23/4279-87

SP 4271 60/4256-70 1000 A $\frac{2}{1}$ mcf

2 bwpn PB 4085 24/4069-77 SSO

1000 A test dry PB 3885 22/3869-77

SSO 1000 A S/20 bw 16 bopd DP to

4085 PB 3920 16/3902-06 S/20 bw

16 bopd PB 3850 22/3830-38 water

-PB 3822 11/3813-17 water PB 3800

23/3787-95 water PB 3780 24/3770-78

water PB 3765 24/3751-59 water

PB 3742 22/3725-33 water PB 3720

12/3716-20 water 12/3707-11

water PB 3702 23/3692-3700 water

PB 3670 12/3656-60 water PB 3650

23/3633-41

JAN 3 1952

D & A Misc

Force Map

France Map

Tracings

and Mail Map

and Small Map

Scout Cards