

# KANSAS

Pratt


FORM 51 5M 10-41 PETROL

Section 25 Township 27 Range 11-W

Well No. #1 J. A. Hoagland

Company Skelly

NORTH Cunningham Pool

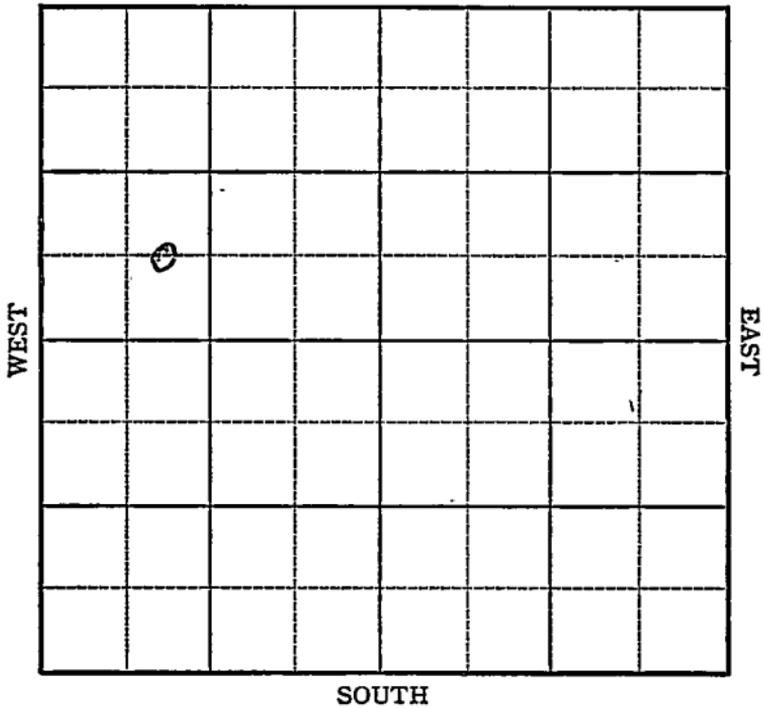

Sec. 25 Twp. 27 R. 11-W

Well No. #1 J. A. Hoagland Farm

Skelly Company

(Cunningham)


\_\_\_\_\_ Ft. from N. Line

660 Ft. from S. Line

\_\_\_\_\_ Ft. from E. Line

990 Ft. from W. Line

*Elev. 1680*

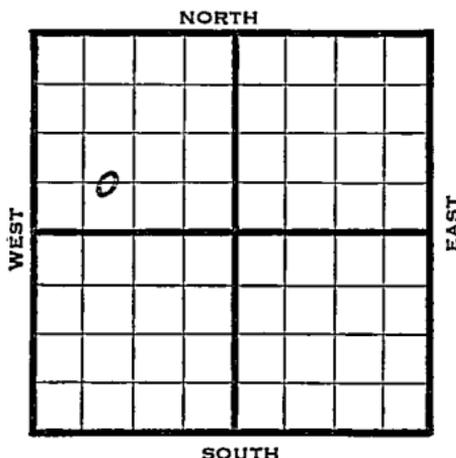

1942

REPORT

7/8	8" - 385' WOC.
7/15	Drlg. 2045'
7/22	Drlg. 3400'
7/29	Lans. 3421- 5" - 3422' Drlg. 3440 No shows.
8/5	T.D. 3472                      6000 acid Pump 50 oil in 4 hrs.
8/12	"                      "                      "
8/19	Lans. 3421 5" - 3422 6000 acid T.D. 3472 Pump 327 Pot. Gravity 4l.

COMPLETED

Pratt

KANSAS

Map No. 54 Sec. 25 Twp. 27 R. 11W

Well No. 1 J. A. Hoagland

Skelly


Company

**FIRST REPORT**

Contractor

C EL SW NW

SECTION PLAT

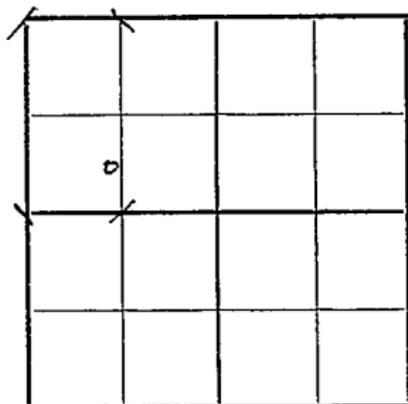

\_\_\_\_\_ Ft. from N. Line

660 Ft. from S. Line

\_\_\_\_\_ Ft. from E. Line

990 Ft. from W. Line

CUNNINGHAM POOL

RECORD

Location \_\_\_\_\_

Cased \_\_\_\_\_ in., \_\_\_\_\_ ft.

Rig up \_\_\_\_\_

Sand \_\_\_\_\_

Drilling and Remarks:

Gas \_\_\_\_\_

8" - 385'

Oil \_\_\_\_\_

Total Depth \_\_\_\_\_

Waiting on  
cement

PRODUCTION

1st 24 hrs. Nat. \_\_\_\_\_

1st 24 hrs. after shot \_\_\_\_\_

Oil only, Drill  
Site

Gas \_\_\_\_\_ Cu. Ft.

Dry Hole \_\_\_\_\_

Abandoned \_\_\_\_\_

Date

JUL 8 1942

19


S. J. LEWIS

Scout

Map No. 54 Sec. 25 Twp. 27 R. 11WWell No. 1 J. A. HoaglandSkelly CompanyCOMPLETED Contractor

C E L S W N W

SECTION PLAT

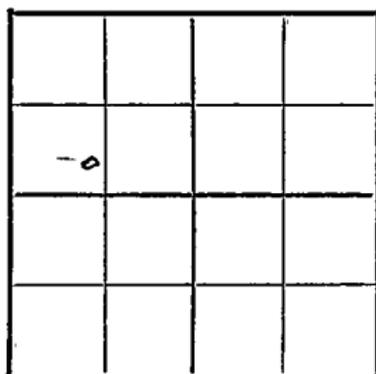         Ft. from N. Line660 Ft. from S. Line         Ft. from E. Line990 Ft. from W. Line

CUNNINGHAM POOL

Location         Rig up         

Drilling and Remarks:

*Law 3421*  
*5" @ 3422*  
*6000 cu ft*  
*Pump 327 P & Y*  
*412/22*

## RECORD

Cased          in.,          ft.Sand         Gas         Oil         Total Depth 3422

## PRODUCTION

1st 24 hrs. Nat.         1st 24 hrs. after shot         Gas          Cu. Ft.Dry Hole         Abandoned         

Date

AUG 19 1942 19 S. J. LEWIS Scout