

KANSAS

Pratt


Form 51-5M-7-39-Palace

Section 25 Township 27 Range 11W

Well No. **#3 Krehbiel**

Company Skelly

NORTH

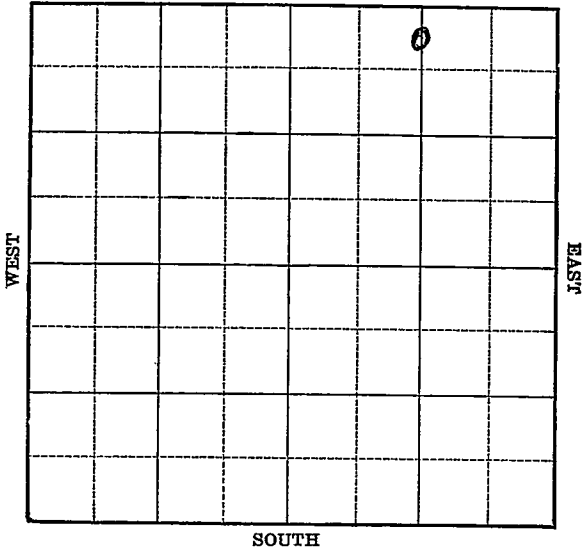

SOUTH

KANSAS

Pratt

Sec. 25 Twp. 27 R. 11-WWell No. #3 Krehbiel FarmSkelly

Company

(Cunningham)


330 Ft. from N. Line

Ft. from S. Line

1320 Ft. from E. Line

Ft. from W. Line

Elev. 1706

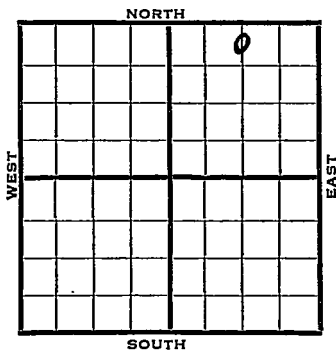

1940

REPORT

7/10

Derrick.

7/18

8" - 344' Drlg. 965'

7/25

Drlg. 3150'

8/2

3450' - 800' oil.

3468' no increases.

8/7

Lans. 3425'

5" - 3436'

T.D. 3477'

2500 acid.

Potential 625 bbls., flow.

1/2 M cu. ft. gas.

COMPLETED

Map No. 54 Sec. 25 Twp. 27 R. 11WWell No. 3 KrehbielSkelly Oil

Company

Contractor

COMPLETED

C N L NE

330 Ft. from N. Line Ft. from S. Line1320 Ft. from E. Line Ft. from W. Line**SECTION PLAT**

CUNNINGHAM POOL

Location Rig up

Drilling and Remarks:

4 ans 84255" @ 34362500 acidFlow. 625 Bx1/2 M Gas**RECORD**Cased in., ft.Sand Gas Oil Total Depth 3477**PRODUCTION**1st 24 hrs. Nat. 1st 24 hrs. after shot Gas Cu. Ft.Dry Hole Abandoned

Date

AUG 7 1940₁₉S. J. LEWIS Scout