

KANSAS

Form 51-5M-7-40-Palace


Pratt

Section 25 Township 27 Range 11-W

Well No. #4 Krehbiel "A"

Company Skelly Oil

NORTH Cunningham Pool

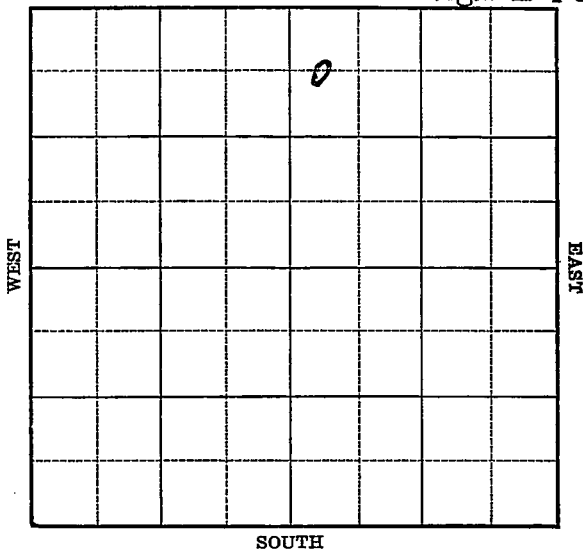

Map No. 54 Sec. 25 Twp. 27 R. 11WWell No. 4 Krehbiel "A"Skelly Oil

Company

FIRST REPORT

Contractor

C W L NW NE

665 Ft. from N. Line Ft. from S. Line Ft. from E. Line334 Ft. from W. Line

CUNNINGHAM POOL

SECTION PLAT

		o	

Location Rig up

Drilling and Remarks:

8" - 373WOC

RECORD

Cased in., ft.Sand Gas Oil Total Depth

PRODUCTION

1st 24 hrs. Nat. 1st 24 hrs. after shot Gas Cu. Ft.Dry Hole Abandoned

Date

NOV 13 1940

19

S. J. LEWIS

Scout

Map No. 54 Sec. 25 Twp. 27 R. 11WWell No. 4 Krehbiel "A"Skelly Oil

Company

Contractor

COMPLETEL

C W L NW NE

665 Ft. from N. Line Ft. from S. Line Ft. from E. Line334 Ft. from W. Line

CUNNINGHAM POOL

SECTION PLAT

		o	

Location Rig up

Drilling and Remarks:

*Loc. 3445**5" @ 3446**7000 @ oil**Flow. 610 P.S.**34.5 Gr.***RECORD**Cased in., ft.Sand Gas Oil Total Depth 3505**PRODUCTION**1st 24 hrs. Nat. 1st 24 hrs. after shot Gas Cu. Ft.Dry Hole Abandoned

Date

DEC 23 1940S. J. LEWIS Scout