


# KANSAS

FORM 51 5M 4-41 PETROL

Section 25 Township 27 Range 11-W

Well No. #7 Krehbiel "A"

Company Skelly Oil  
(Cunningham)

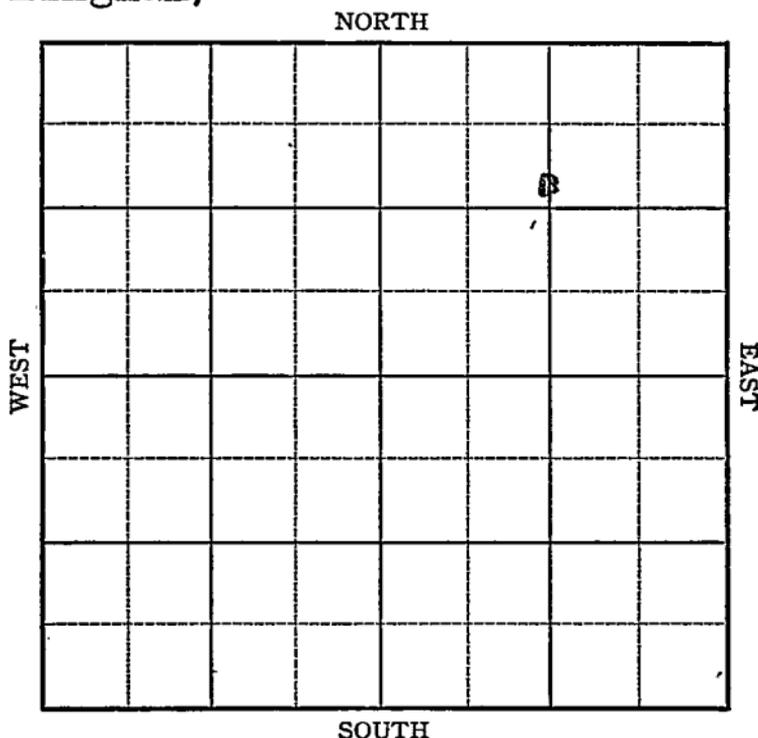

Sec. 25 Twp. 27 R. 11-W

Well No. #7 Krehbiel "A" Farm

Skelly Oil Company  
(Cunningham Pool)


990 Ft. from N. Line

Ft. from S. Line

1320 Ft. from E. Line

Ft. from W. Line

Elev. 1698

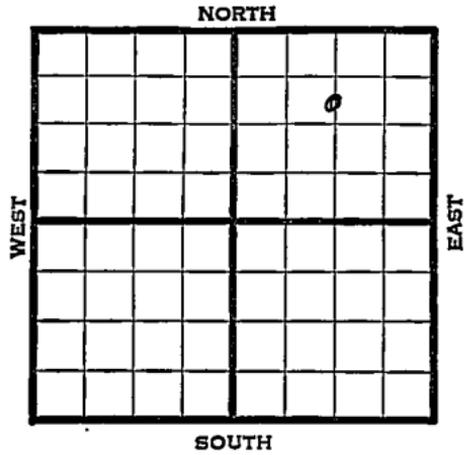

1941	REPORT
8/6	Location
8/15	Bld.g Rot. Rig
8/21	8" - 360' Drlg. 1560'
8/28	Drlg. 3390'
9/4	Lans. 3421' 5" - 3423'
	T.D. 3480' 800' oil 9 hours.
9/10	Lans. 3421'
	5" - 3423'
	T.D. 3480'
	7000 acid.
	Potential 392 bbls., pump.
	34.5 Gravity
	<b>COMPLETED</b>

**KANSAS**

Map No. 54 Sec. 25 Twp. 27 R. 11W

Well No. 7 Krehbiel "A"


Skelly Oil Company

~~FIRST REPORT~~ Contractor

C S L N  $\frac{1}{2}$  NE

**SECTION PLAT**

990 Ft. from N. Line

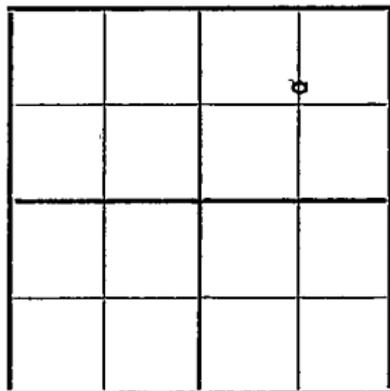

\_\_\_\_\_ Ft. from S. Line

1320 Ft. from E. Line

\_\_\_\_\_ Ft. from W. Line

**CUNNINGHAM POOL**

Location X

Rig up \_\_\_\_\_

Drilling and Remarks:

**RECORD**

Cased \_\_\_\_\_ in., \_\_\_\_\_ ft.

Sand \_\_\_\_\_

Gas \_\_\_\_\_

Oil \_\_\_\_\_

Total Depth \_\_\_\_\_

**PRODUCTION**

1st. 24 hrs. Nat. \_\_\_\_\_

1st 24 hrs. after shot \_\_\_\_\_

Gas \_\_\_\_\_ Cu. Ft.

Dry Hole \_\_\_\_\_

Abandoned \_\_\_\_\_

Date

AUG 6 1941 19

S. J. LEWIS Scout

Map No. 54 Sec. 25 Twp. 27 R. 11W

Well No. 7 Krehbiel "A"

Skelly Oil Company

~~COARLETTED~~ Contractor

**SECTION PLAT**


C S L N $\frac{1}{2}$  NE  
990 Ft. from N. Line

\_\_\_\_\_ Ft. from S. Line

1320 Ft. from E. Line

\_\_\_\_\_ Ft. from W. Line

**CUNNINGHAM POOL**

**RECORD**

Location \_\_\_\_\_

Cased \_\_\_\_\_ in., \_\_\_\_\_ ft.

Rig up \_\_\_\_\_

Sand \_\_\_\_\_

Drilling and Remarks:

Gas \_\_\_\_\_

Oil \_\_\_\_\_

Total Depth 3450

*have 3421*

*5" @ 3423*

*7000 Acid*

*Pump 392 PJ*

**PRODUCTION**

1st 24 hrs. Nat. \_\_\_\_\_

1st 24 hrs. after shot \_\_\_\_\_

Gas \_\_\_\_\_ Cu. Ft.

Dry Hole \_\_\_\_\_

Abandoned \_\_\_\_\_

*3450*

Date

SEP 10 1941 19

S. J. LEWIS Scout