


Map No. KANSAS (Sec. 25 Twp. 27 R. 11W)  
Well No. F. Madsen Farm  
Skelly Oil Company

NORTH

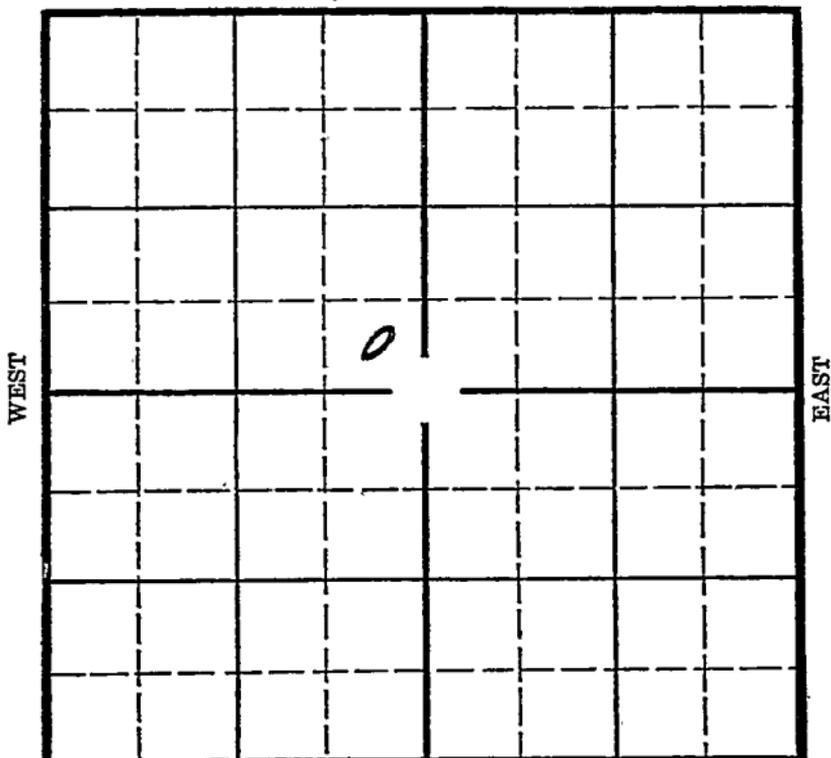

SOUTH

Location \_\_\_\_\_  
Drilling Remarks \_\_\_\_\_

Rig Up \_\_\_\_\_  
Drilling Remarks \_\_\_\_\_

\_\_\_\_\_  
\_\_\_\_\_  
**RECORD**

**PRODUCTION**

Cased \_\_\_\_\_ in. \_\_\_\_\_ ft.  
Sand \_\_\_\_\_  
Gas \_\_\_\_\_  
Oil \_\_\_\_\_  
Total Depth \_\_\_\_\_

1st 24 hrs. Nat. \_\_\_\_\_  
1st 24 hrs. after shot \_\_\_\_\_  
Gas \_\_\_\_\_ cu. ft. \_\_\_\_\_  
Dry Hole \_\_\_\_\_  
Abandoned \_\_\_\_\_

Pratt  
25 27 11W

Map No. \_\_\_\_\_ Sec. 25 Typ. 27 R. 11W

Well No. 1- Mafedon Farm


Skelly Oil Company

\_\_\_\_\_ Ft. from N. Line

330 Ft. from S. Line

330 Ft. from E. Line

\_\_\_\_\_ Ft. from W. Line

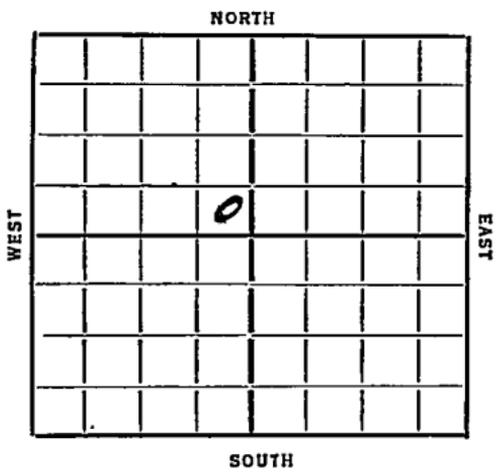

Elev. 1683

REPORT

Date

9/12

Location

10/3

Log

10/10

Dlg 1130 12" 307

11/4

Dlg cement

11/6

KEL 3421

TD 3457

2000 FT

244 Poles

COMPLETED

Map No. 54 Sec. 25 Twp. 27 R. 11W

Well No. 1 - Mopedon

Skelly oil Company  
 Contractor

FIRST REPORTS

SECTION PLAT

.....Ft. from N. Line

330 Ft. from S. Line

330 Ft. from E. Line

.....Ft. from W. Line

	0		

Location

Rig up

Drilling and Remarks:

RECORD

Cased.....in., .....ft.

Sand.....

Gas.....

Oil.....

Total Depth.....

PRODUCTION

1st 24 hrs. Nat.....

1st 24 hrs. after shot.....

Gas.....Cu. Ft.

Dry Hole.....

Abandoned.....

Date

9-12-35 192

ORVAL MANNSCHRECK

Scout

KANSAS

Map No. 54 Sec. 25 Twp. 27 R. 11W

Well No. 1-7 Mafedon

Skelly Oil Company

Contractor

COMPLETED

SECTION PLAT

	0		

..... Ft. from N. Line

330 Ft. from S. Line

330 Ft. from E. Line

..... Ft. from W. Line

Location.....

Rig up.....

Drilling and Remarks:

2000 H

244 bbls

RECORD

Cased..... in. .... ft.

~~Strat~~ K.C.L. 3421

Gas.....

Oil.....

Total Depth 3457

PRODUCTION

1st 24 hrs. Nat.....

1st 24 hrs. after shot.....

Gas..... Cu. Ft.

Dry Hole.....

Abandoned.....

Date

1-6-35 192.....

ORVAL MANSCHEFF OK

Scout