


# PRATT

Form 51-5M-3-35-Mid-West

Map No. **KANSAS** Sec. **25** Twp. **27** R. **11-W**  
 Well No. **3-East Maxedon** Farm  
**Skelly Oil** Company

NORTH

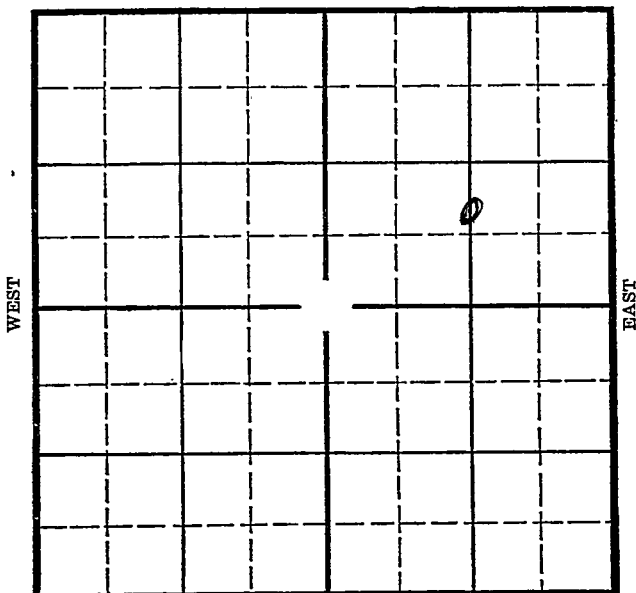

SOUTH

Location \_\_\_\_\_  
 Drilling Remarks \_\_\_\_\_

Rig Up \_\_\_\_\_  
 Drilling Remarks \_\_\_\_\_

\_\_\_\_\_  
 \_\_\_\_\_  
## RECORD

Cased \_\_\_\_\_ in. \_\_\_\_\_ ft.  
 Sand \_\_\_\_\_  
 Gas \_\_\_\_\_  
 Oil \_\_\_\_\_  
 Total Depth \_\_\_\_\_

## PRODUCTION

1st 24 hrs. Nat. \_\_\_\_\_  
 1st 24 hrs. after shot \_\_\_\_\_  
 Gas \_\_\_\_\_ cu. ft.  
 Dry Hole \_\_\_\_\_  
 Abandoned \_\_\_\_\_



6/25--

7/2-Drlg. 4199'. 13 million gas. 5 bbls  
of oil per hour.

8/9-T.D. 4200'. Flow 75 bbls of oil.  
27% water.  $1\frac{1}{2}$  million cuft. of gas.

7/15/36-Sil. 4170'.  
T.D. 4200'.  
75 bbls of oil.  
 $1\frac{3}{4}$  million cubic feet of gas.  
35% water.

**COMPLETED**

Map No. 54 Sec. 25 Twp. 27 R. 11W

Well No. 3- East Marion

Shelly oil Company

Contractor

# FIRST REPORTS


## SECTION PLAT

Ft. from N. Line

880 Ft. from S. Line

1320 Ft. from E. Line

Ft. from W. Line

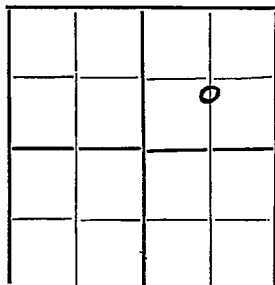

Location

Rig up

Drilling and Remarks:

## RECORD

Cased in., ft.

Sand

Gas

Oil

Total Depth

## PRODUCTION

1st 24 hrs. Nat.

1st 24 hrs. after shot

Gas Cu. Ft.

Dry Hole

Abandoned

Date

ORVAL MANNSCHRECK

3-11-36 192 Scout

511

Turned

Map No. 54 Sec. 25 Twp. 27 R. 11WWell No. 3 East MayadonShelly Oil Company

Contractor

## SECTION PLAT

|  |  |   |  |
|--|--|---|--|
|  |  |   |  |
|  |  | 0 |  |
|  |  |   |  |
|  |  |   |  |

\_\_\_\_ Ft. from N. Line

780 Ft. from S. Line1820 Ft. from E. Line

\_\_\_\_ Ft. from W. Line

COMPLETED

Location \_\_\_\_\_

Rig up \_\_\_\_\_

Drilling and Remarks:

Oil 417075 oil1 3/4 M Gas.3 5/8 water

## RECORD

Cased \_\_\_\_\_ in., \_\_\_\_\_ ft.

Sand \_\_\_\_\_

Gas \_\_\_\_\_

Oil \_\_\_\_\_

Total Depth 4200

## PRODUCTION

1st 24 hrs. Nat. \_\_\_\_\_

1st 24 hrs. after shot \_\_\_\_\_

Gas \_\_\_\_\_ Cu. Ft.

Dry Hole \_\_\_\_\_

Abandoned \_\_\_\_\_

Date

JUL 15 1936 19S. J. LEWIS Scout

*[Handwritten signature]*

|                       |                    |
|-----------------------|--------------------|
| Returned              | <i>[Signature]</i> |
| Cards                 | <i>[Signature]</i> |
| Tracing               | <i>[Signature]</i> |
| France Map            | <i>[Signature]</i> |
| Scarborough Map       | <i>[Signature]</i> |
| Moody Map             | <i>[Signature]</i> |
| Scarborough Plat Book | <i>[Signature]</i> |
| Moody Plat Book       | <i>[Signature]</i> |