

KANSAS

Pratt

FORM 51 5M 4-41 PETROL


Section 25 Township 27 Range 11-W

Well No. 7 East Maxedon (Twin #3)

Company Skelly Oil

Cunningham Pool

NORTH

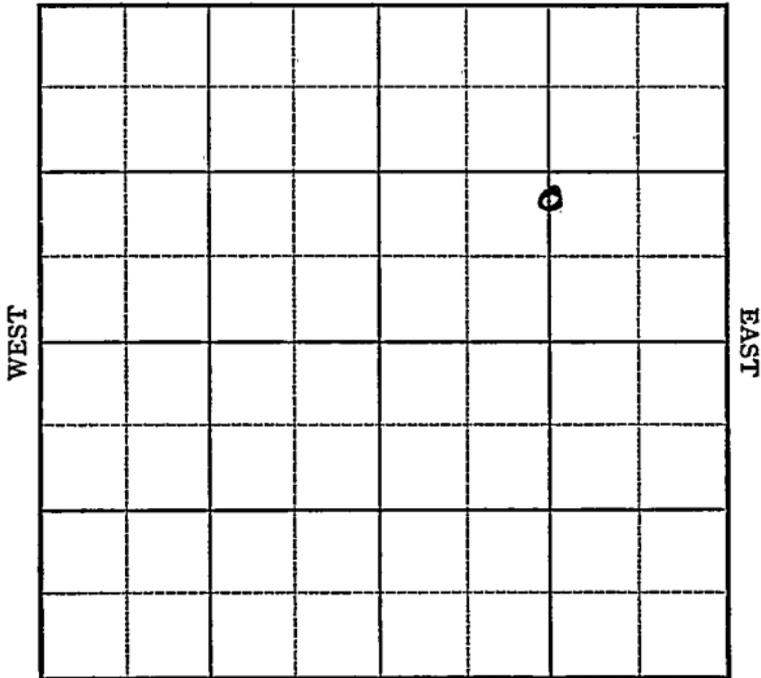

SOUTH

Map No. 54 Sec. 25 Twp. 27 R. 11WWell No. 7 East Maxedon (Twin #3)Skelly Oil CompanyCOMPLETED ContractorC N L S $\frac{1}{2}$ NE

_____ Ft. from N. Line

995 Ft. from S. Line1336 Ft. from E. Line

_____ Ft. from W. Line

CUNNINGHAM POOL

SECTION PLAT

Location _____

Rig up _____

Drilling and Remarks:

Log 3410
5" @ 3411
7000 Acrid
Pump 503 RY

RECORD

Cased _____ in., _____ ft.

Sand _____

Gas _____

Oil _____

Total Depth 3466

PRODUCTION

1st 24 hrs. Nat. _____

1st 24 hrs. after shot _____

Gas _____ Cu. Ft.

Dry Hole _____

Abandoned _____

Date

JUN 4 1941S. J. LEWIS Scout