

KANSAS

Form 51-5M-11-38-Palace


Pratt

Section 25 Township 27 Range 11-W

Well No. #5 East Maxedon

Company Skelly Oil

NORTH **Cunningham Pool**

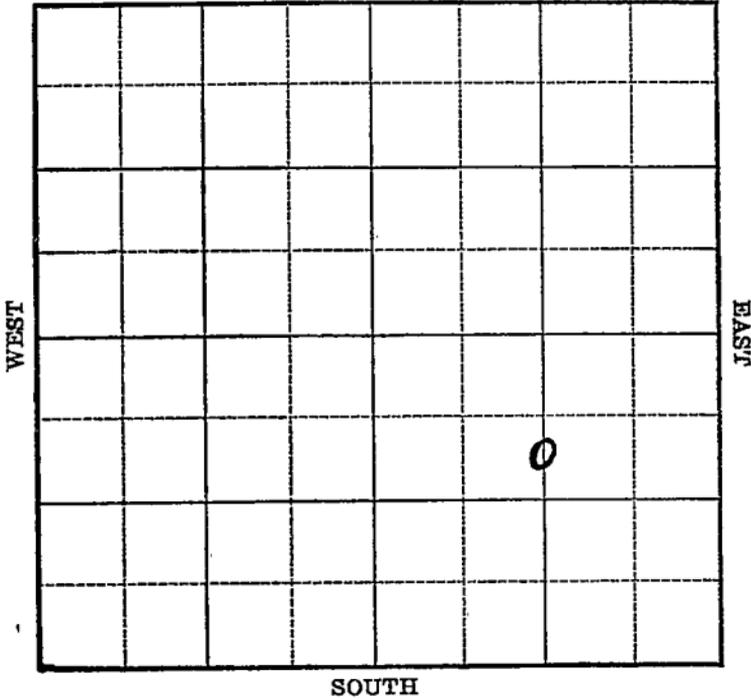

Sec. 25 Twp. 27 R. 11-W

Well No. #5 East Maxedon Farm _____

Skelly Oil Company _____

(Cunningham)


990 Ft. from N. Line

_____ Ft. from S. Line

1332 Ft. from E. Line

_____ Ft. from W. Line

Elev. 1668

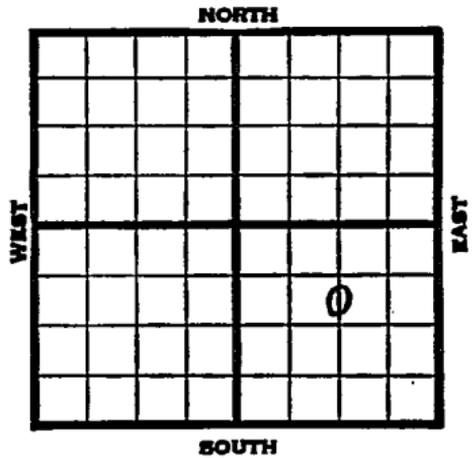

1939	REPORT
11/8	Rotary.
11/16	10" - 360' Drlg. 1225'
11/23	Drlg. 2900'
11/29	Lans. 3398' 5" - 3400' T.D. 3405' S.O. RUST.
12/7	Drlg. 3411' 1800' oil. 12 hrs. 5 M cu. ft. gas.
12/14	Pay 3429-3000' Pay 3429-33' Pay 3439-51' T.D. 7000 acid. Testing.
12/20	Lans. 3398' 5 1/2" - 3400' T.D. 3451' 7000 acid. Flow 406 bbls., potential.
COMPLETED	

Map No. 54 Sec. 25 Twp. 27 R. 11WWell No. 5 East MaxedonSkelly Oil

Company

Contractor

FIRST REPORT

C S L N $\frac{1}{2}$ SE

SECTION PLAT

			○

990 Ft. from N. Line

_____ Ft. from S. Line

1332 Ft. from E. Line

_____ Ft. from W. Line

CUNNINGHAM POOL

Location _____

Rig up _____

Drilling and Remarks:

Rotary

RECORD

Cased _____ in., _____ ft.

Sand _____

Gas _____

Oil _____

Total Depth _____

PRODUCTION

1st 24 hrs. Nat. _____

1st 24 hrs. after shot _____

Gas _____ Cu. Ft.

Dry Hole _____

Abandoned _____

Date

NOV 8 1939 19

S. J. LEWIS Scout

Misc Small Maps	RAY
Cards	RAY
Tide rig	RAY
Fr	RAY
Co	RAY
Job	RAY
Group & Dept	
Loc + B	

Map No. 54 Sec. 25 Twp. 27 R. 11W

Well No. 5 East Maxedon

Skelly

Company

Contractor

COMPLETED

C S I N $\frac{1}{2}$ SE

990 Ft. from N. Line

_____ Ft. from S. Line

1332 Ft. from E. Line

_____ Ft. from W. Line

SECTION PLAT

			o

CUNNINGHAM POOL

Location _____

Rig up _____

Drilling and Remarks:

logs 3398.

5 1/2" @ 3400

7000 acid

Flow 406 P.S.

RECORD

Cased _____ in., _____ ft.

Sand _____

Gas _____

Oil _____

Total Depth 3451

PRODUCTION

1st 24 hrs. Nat. _____

1st 24 hrs. after shot _____

Gas _____ Cu. Ft.

Dry Hole _____

Abandoned _____

Date

DEC. 20 1939 19

S. J. LEWIS Scout

small maps

Misc Small Maps	
Cards	<i>Paul</i>
Tracing	<i>Paul</i>
France Map	<i>Paul</i>
Scarborough Map	<i>Paul</i>
Moody Map	<i>Paul</i>
Geological Dept.	
Moody Flat Book	