


# KANSAS Pratt

FORM 51 5M 4-41 PETROL

Section 25 Township 27 Range 11-W

Well No. #8 East Maxedon

Company Skelly

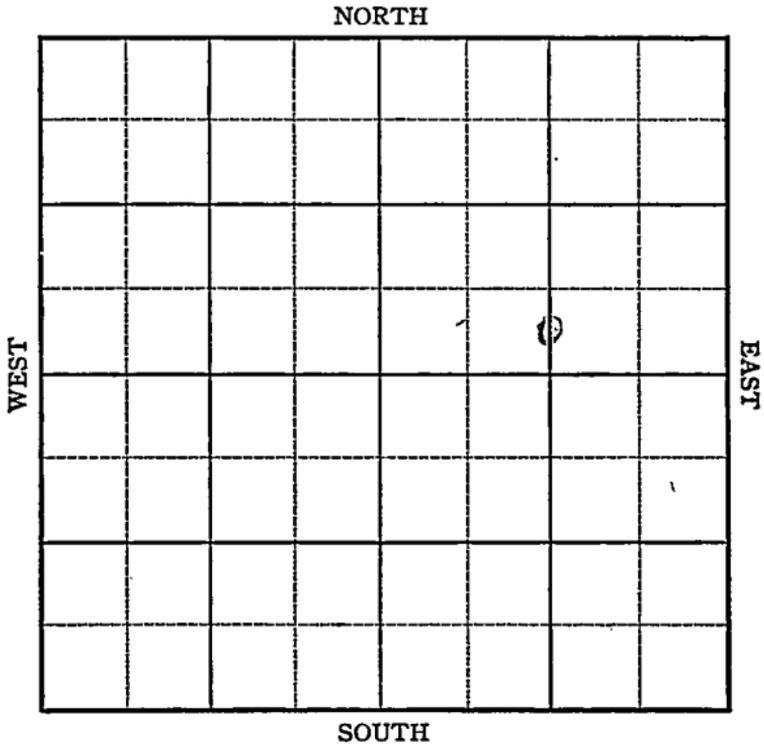

Sec 25 Twp. 27 R. 11-W

Well No. #8 East Maxedon Farm

Skelly Company


(Cunningham)

\_\_\_\_\_ Ft. from N. Line

330 Ft. from S. Line

1320 Ft. from E. Line

\_\_\_\_\_ Ft. from W. Line

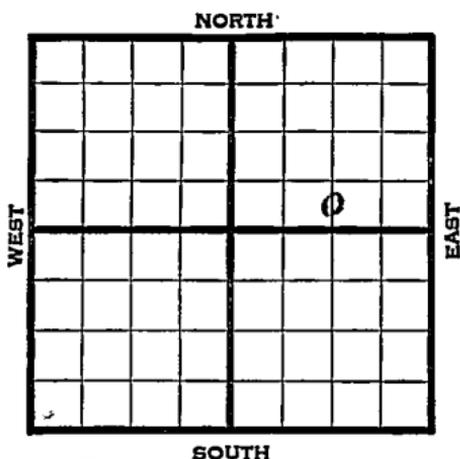

Elev. 1678

1941 REPORT	
10/29	Location
11/6	Derrick.
11/13	8" - 352' Drlg. 950'
11/20	Lans. <sup>3403</sup> 3405' 5" - <sup>3409</sup> 3409'
	T.D. 3410' RUST.
11/28	Lans. 3403' (Corrected)
	5" - 3407' Drlg. 3453'
	800' oil 20 hours.
12/3	Lans. 3403'
	5" - 3407'
	T.D. 3464'
	7000 acid.
	Potential 236 bbls. plus 24% water on pump.
	41. Gravity
<b>COMPLETED</b>	

Pratt

**KANSAS**

Map No. H-54 Sec. 25 Twp. 27 R. 11W

Well No. 8 East Maxedon

Skelly

Company

**FIRST REPORT**

Contractor

C SL NE

**SECTION PLAT**

			○

\_\_\_\_\_ Ft. from N. Line

330 Ft. from S. Line

1320 Ft. from E. Line

\_\_\_\_\_ Ft. from W. Line

**CUNNINGHAM POOL**

Location XX

Rig up \_\_\_\_\_

Drilling and Remarks:

**RECORD**

Cased \_\_\_\_\_ in., \_\_\_\_\_ ft.

Sand \_\_\_\_\_

Gas \_\_\_\_\_

Oil \_\_\_\_\_

Total Depth \_\_\_\_\_

**PRODUCTION**

1st 24 hrs. Nat. \_\_\_\_\_

1st 24 hrs. after shot \_\_\_\_\_

Gas \_\_\_\_\_ Cu. Ft.

Dry Hole \_\_\_\_\_

Abandoned \_\_\_\_\_

Date

OCT 29 1941 19

S. J. LEWIS Scout

