


Form 51—5M—11-38—Palace

Pratt

Section 25 Township 27 Range 11-WWell No. #1 South MaxedonCompany Skelly

NORTH Cunningham Pool

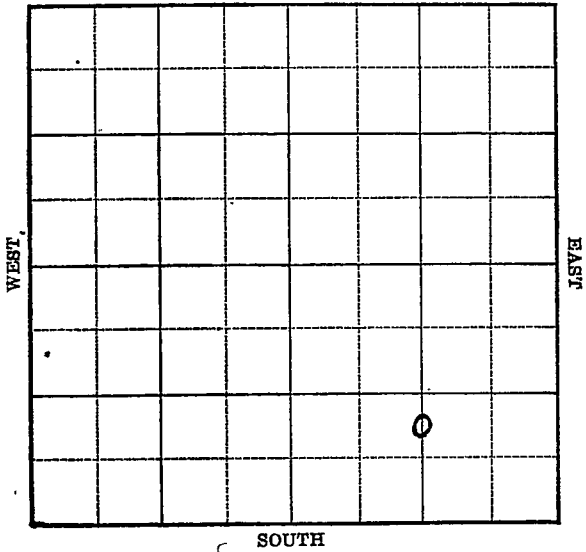

Pratt

Sec. 25 Twp. 27 R. 11-W

Well No. #1 South Maxedon Farm

Skelly

Company

(Cunningham)


_____ Ft. from N. Line

990 Ft. from S. Line

1332 Ft. from E. Line

Ft. from W. Line

Elev. 1669

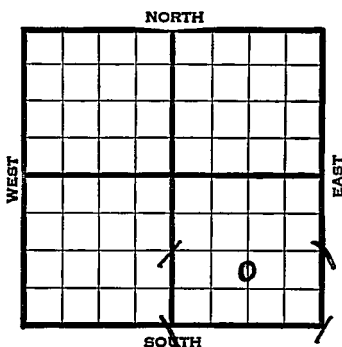[illegible]

Map No. 54 Sec. 25 Twp. 27 R. 11WWell No. 1 South MaxedonSkelly


Company

Contractor

FIRST REPORT

C N L S $\frac{1}{2}$ SE Ft. from N. Line990 Ft. from S. Line1332 Ft. from E. Line Ft. from W. Line

SECTION PLAT

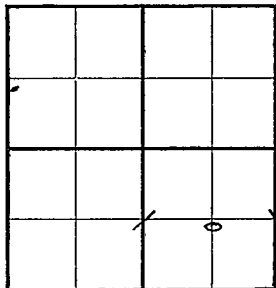

CUNNINGHAM POOL

Location Rig up Drilling and Remarks:

Rotary

RECORD

Cased in., ft.Sand Gas Oil Total Depth

PRODUCTION

1st 24 hrs. Nat. 1st 24 hrs. after shot Gas Cu. Ft.Dry Hole Abandoned

Date

AUG 2 1930 19 S. J. LEWIS Scout

Pratt

KANSAS

Map No. 54 Sec. 25 Twp. 27 R. 11WWell No. 1 South Maxedon

Skelly

Company

Contractor

COMPLETED

C N L S $\frac{1}{2}$ SE


Ft. from N. Line

990 Ft. from S. Line1332 Ft. from E. Line

Ft. from W. Line

CUNNINGHAM POOL

SECTION PLAT

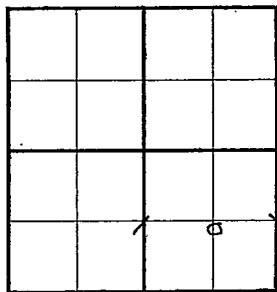

Location _____

Rig up _____

Drilling and Remarks:

*Lane 3402**5" @ 3410**6000 acid**Flow 772 Pst.*

RECORD

Cased _____ in., _____ ft.

Sand _____

Gas _____

Oil _____

Total Depth 3458 1/2

PRODUCTION

1st 24 hrs. Nat. _____

1st 24 hrs. after shot _____

Gas _____ Cu. Ft.

Dry Hole _____

Abandoned _____

Date

SEP 13 1939

19

S. J. LEWIS

Scout