

KANSAS


Pratt

Form 51-5M-7-39-Palace

Section 25 Township 27 Range 11-W

Well No. #2 South Maxedon

Company Skelly

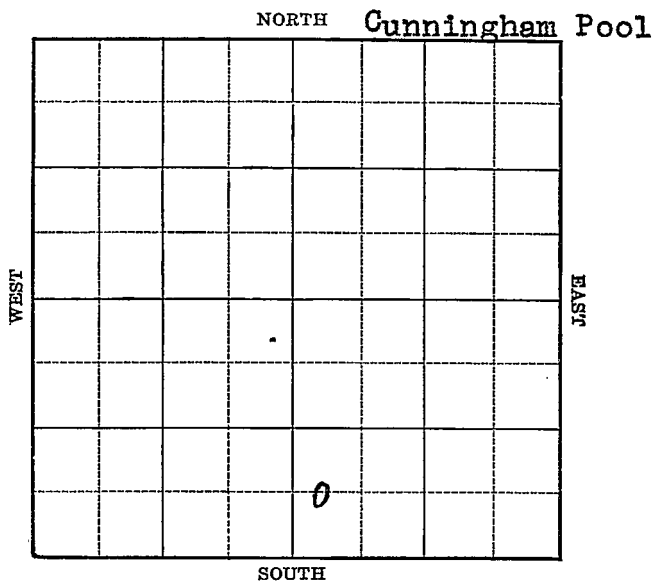

KANSAS


Pratt

Sec. 25 Twp. 27 R. 11-WWell No. #2 South Maxedon FarmSkelly Company

(Cunningham)

 Ft. from N. Line660 Ft. from S. Line Ft. from E. Line330 Ft. from W. Line

Elev. 1675

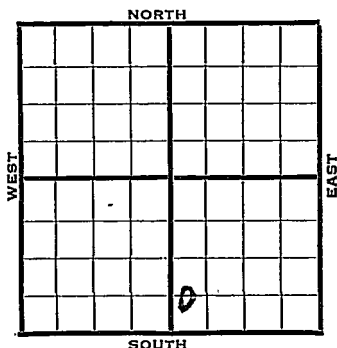

1940	REPORT
4/24	Rotary.
5/2	10" - 410' Drlg. 1975'
5/9	Drlg. 3280'
5/16	Lansing 3408' SO 3412-18'
	5" - 3413' RUST.
5/22	Lans. 3408'
	5" - 3413'
	T.D. 3469'
	7000 acid.
	Potential 545 bbls., pump & flow

COMPLETED

Map No. 54 Sec. 25 Twp. 27 R. 11WWell No. 2 South MaxedonSkelly

Company

Contractor

FIRST REPORT

C W L SW SE

Ft. from N. Line

660

Ft. from S. Line

Ft. from E. Line

330

Ft. from W. Line

SECTION PLAT

		0	

CUNNINGHAM POOL

Location _____

Rig up _____

Drilling and Remarks:

Rotary

RECORD

Cased _____ in., _____ ft.

Sand _____

Gas _____

Oil _____

Total Depth _____

PRODUCTION

1st 24 hrs. Nat. _____

1st 24 hrs. after shot _____

Gas _____ Cu. Ft.

Dry Hole _____

Abandoned _____

Date

APR 24 1940

19

S. J. LEWIS

Scout

Map No. 54 Sec. 25 Twp. 27 R. 11WWell No. 2 South MaxedonSkelly

Company

Contractor

COMPLETED

C W L S V SE

Ft. from N. Line

660

Ft. from S. Line

Ft. from E. Line

330

Ft. from W. Line

CUNNINGHAM POOL

SECTION PLAT

		0	

Location _____

Rig up _____

Drilling and Remarks:

*Loss 3408'**5" @ 3413**7000 cu. ft.**Pump Flow 128**545***RECORD**

Cased _____ in., _____ ft.

Sand _____

Gas _____

Oil _____

Total Depth 3469**PRODUCTION**

1st 24 hrs. Nat. _____

1st 24 hrs. after shot _____

Gas _____ Cu. Ft.

Dry Hole _____

Abandoned _____

Date

MAY 22 1940₁₉

S. J. LEWIS Scout