

KANSAS

Pratt


Form 51-5M-7-39-Palace

Section 25 Township 27 Range 11-W

Well No. #3 South Maxedon

Company Skelly

NORTH **Cunningham Pool**

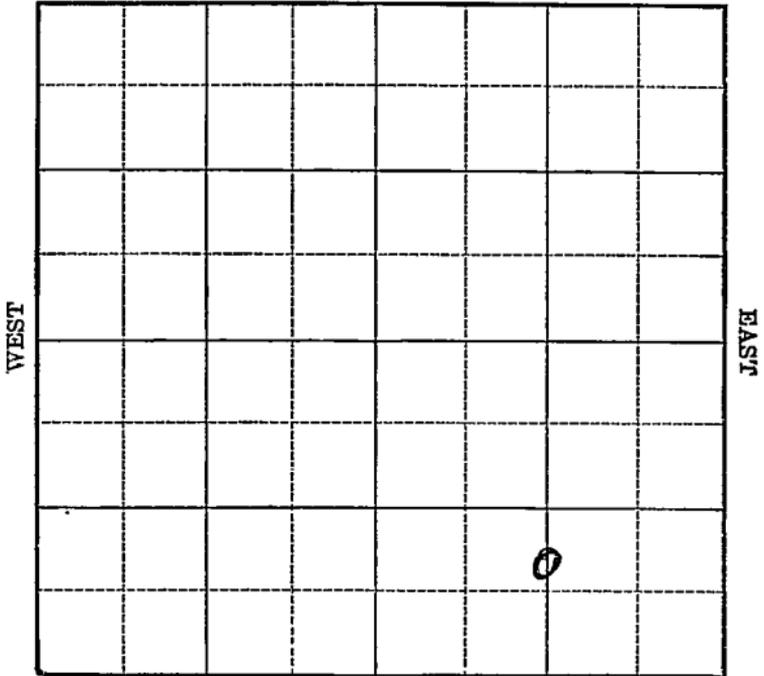

SOUTH

Sec. 25 Twp. 27 R. 11-W

Well No. #3 South Maxedon Farm

Skelly Company


(Cunningham)

_____ Ft. from N. Line

720 Ft. from S. Line

1332 Ft. from E. Line

_____ Ft. from W. Line

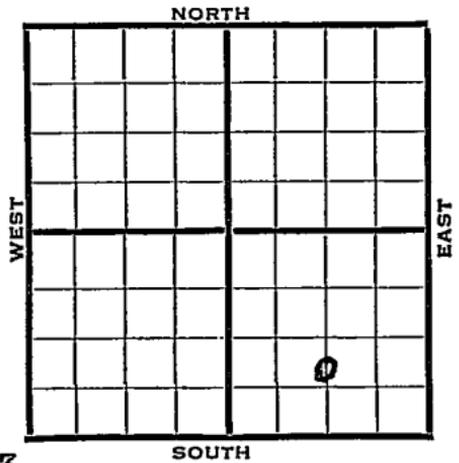

Elev. 1673

1940	REPORT
4/24	10" - 396' WOC.
5/2	Drlg. 2805'
5/9	Lans. 3408' Kind. 3936'
	Viola 3998' T.D. 4008' Run 5".
5/16	5" - 4000' T.D. 4018'
	24 M gas. 1000 acid.
	74,200,000 gas.
5/23	" " "
5/29	" " "
6/6	" " "
6/13	" " "
6/19	Viola 3998'
	5" - 4000'
	T.D. 4018'
	1000 acid.
	67 M cu. ft. gas.
	COMPLETED

We show Skelly #1, at approximately this same location.

Misc. Small Maps.....	<i>Paul</i>
Cards.....	<i>Paul</i>
Tracing.....	<i>Jim</i>
France Map.....	<i>Paul</i>
Scarborough Map.....	<i>Paul</i>
Moody Map.....	<i>Paul</i>
Geological Dept.	
Moody Flat Book	

Map No. _____ Sec. 25 Twp. 27 R. 11W

Well No. 3 South Maxedon

Skelly Company

CORRECTION Contractor

C N L $S\frac{1}{2}$ SE

SECTION PLAT

_____ Ft. from N. Line

720 Ft. from S. Line

1332 Ft. from E. Line

_____ Ft. from W. Line

CUNNINGHAM POOL

Location _____

RECORD

Rig up _____

Cased _____ in., _____ ft.

Drilling and Remarks:

Sand _____

Gas _____

Oil _____

Total Depth _____

#1 Was an oilwell
in Lansing and
this well is to
be a gas well in
Viola

PRODUCTION

1st 24 hrs. Nat. _____

1st 24 hrs. after shot _____

Gas _____ Cu. Ft.

Dry Hole _____

Abandoned _____

Date

MAY 2 1940₁₉

S. J. LEWIS

Scout

Misc Small Maps.....	<i>RM</i>
Cards.....	<i>RM</i>
Tracing.....	<i>JRM</i>
France Map.....	<i>RM</i>
Scarborough Map.....	<i>RM</i>
Moody Map.....	<i>RM</i>
Geological Dept.	
Moody Flat Book	