

# KANSAS

Form 51-5M-7-39-Palace


Pratt

Section 25 Township 27 Range 11-W

Well No. #2 West Maxedon

Company Skelly

NORTH Cunningham Pool

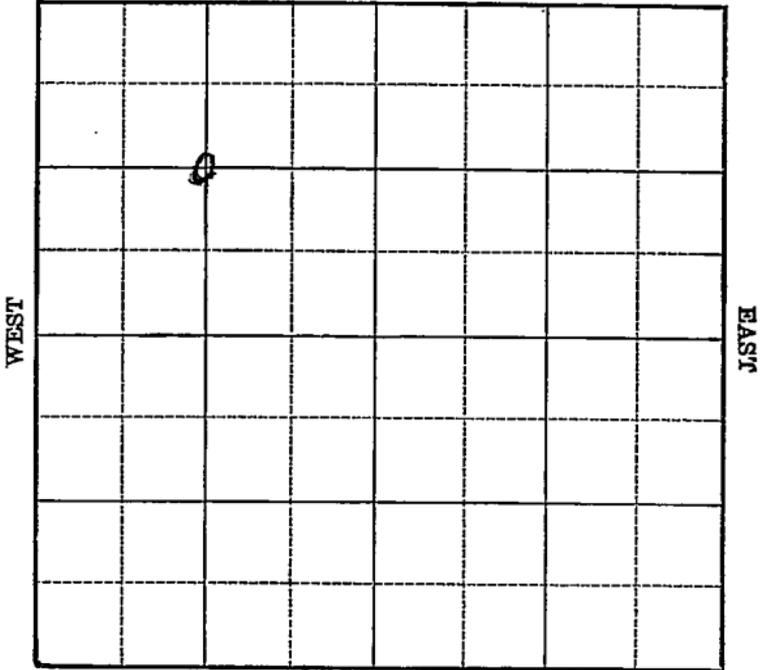

SOUTH

Sec. 25 Twp. 27 R. 11-W

Well No. #2 West Maxedon Farm

Skelly Company

(Cunningham)


1326 Ft. from N. Line

Ft. from S. Line

1287 Ft. from E. Line

Ft. from W. Line

**Elev. 1688**

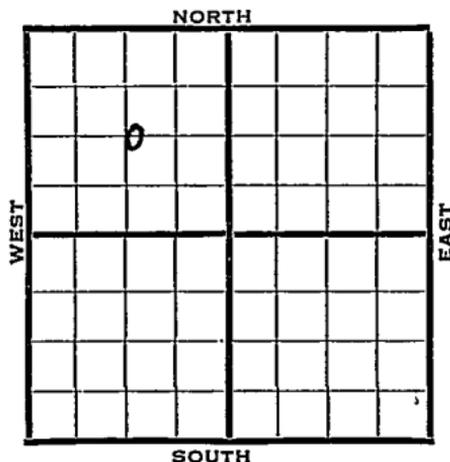

1940	REPORT
4/24	10" - 396' WOC.
5/2	Drlg. 2725'
5/9	Kind. 3976' Viola 4035-4039' TD Run 5".
5/16	5" - 4036' T.D. 4044' Fsg.
5/23	" " " " "
5/29	" " " " "
6/6	" " " " "
6/13	T.D. 4055' 1000 acid. 74½ M gas.
6/19	Viola 4035' 5" - 4036' T.D. 4055' 1000 acid. 58 M gas.

**COMPLETED**


Map No. 54 Sec. 25 Twp. 27 R. 11WWell No. 2 West MaxedonSkelly

Company

**FIRST REPORT**

Contractor

C NW

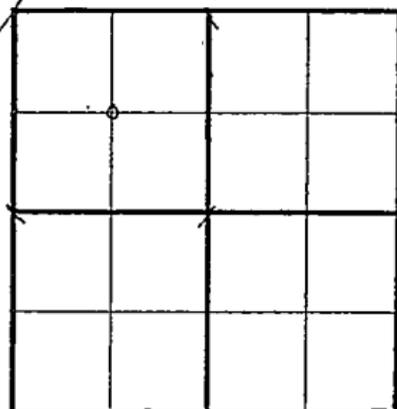**SECTION PLAT**1326 Ft. from N. Line

\_\_\_\_\_ Ft. from S. Line

1287 Ft. from E. Line

\_\_\_\_\_ Ft. from W. Line

**CUNNINGHAM POOL**

Location \_\_\_\_\_

Rig up \_\_\_\_\_

Drilling and Remarks:

10" - 396  
WOC

**RECORD**

Cased \_\_\_\_\_ in., \_\_\_\_\_ ft.

Sand \_\_\_\_\_

Gas \_\_\_\_\_

Oil \_\_\_\_\_

Total Depth \_\_\_\_\_

**PRODUCTION**

1st 24 hrs. Nat. \_\_\_\_\_

1st 24 hrs. after shot \_\_\_\_\_

Gas \_\_\_\_\_ Cu. Ft.

Dry Hole \_\_\_\_\_

Abandoned \_\_\_\_\_

Date

APR 24 1940

19

S. J. LEWIS Scout

Map No. 54 Sec. 25 Twp. 27 R. 11WWell No. 2 West MaxedonSkelly Oil

Company


Contractor

**COMPLETED**

C NW

1326 Ft. from N. Line       Ft. from S. Line1287 Ft. from E. Line       Ft. from W. Line

CUNNINGHAM POOL

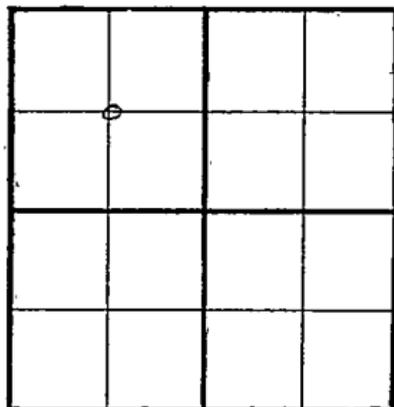**SECTION PLAT**

Location \_\_\_\_\_

Rig up \_\_\_\_\_

Drilling and Remarks:

*Viola 4035**5" C 4036**1000 acid**58 M Gas***RECORD**

Cased \_\_\_\_\_ in., \_\_\_\_\_ ft.

Sand \_\_\_\_\_

Gas \_\_\_\_\_

Oil \_\_\_\_\_

Total Depth 4055**PRODUCTION**

1st 24 hrs. Nat. \_\_\_\_\_

1st 24 hrs. after shot \_\_\_\_\_

Gas \_\_\_\_\_ Cu. Ft.

Dry Hole \_\_\_\_\_

Abandoned \_\_\_\_\_

Date

JUN 19 1940 19S. J. LEWIS Scout