

KANSAS

Form 51-5M-7-40-Palace


Pratt

Section 25 Township 27 Range 11-W

Well No. #3 West Maxedon

Company Skelly Oil

NORTH Gunningham Pool

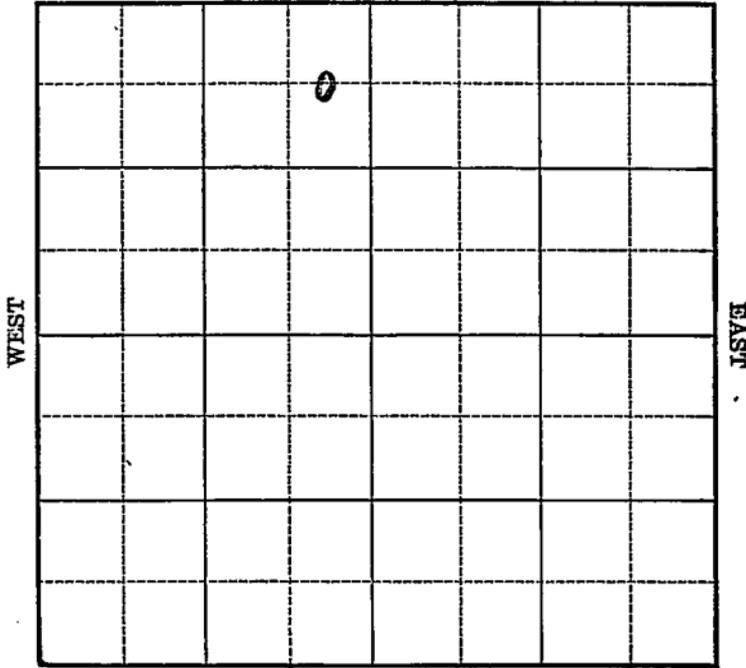

SOUTH

Sec. 25 Twp. 27 R. 11-W

Well No. #3 West Maxedon Farm

Skelly Oil Company

(Cunningham)


660 Ft. from N. Line

_____ Ft. from S. Line

330 Ft. from E. Line

_____ Ft. from W. Line

Elev. 1701

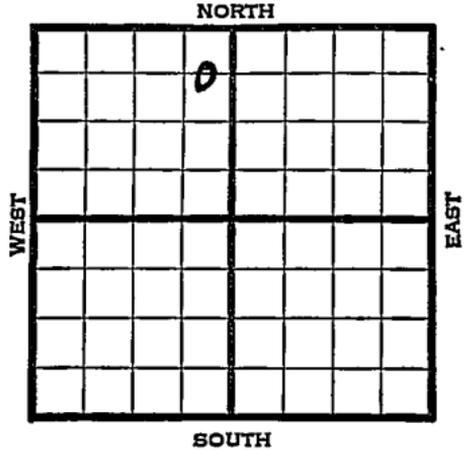

1941	REPORT
2/26	Rotary.
3/6	8" - 368' WOC.
3/13	Drlg. 2680'
3/20	Lans. 3426 ³⁴²⁶ 5" - 3423 ³⁴²⁶ T.D. 3441' Sat. RUST.
3/26	Lans. 3426' (Corrected)
	5" - 3426'
	T.D. 3491'
	7000 acid.
	Potential 55l bbls., flow.
	1-7/10 M gas.
	34.5 Gravity
	COMPLETED

Map No. 54 Sec. 25 Twp. 27 R. 11WWell No. 3 West Maxedon

Skelly Oil

Company

FIRST REPORT

Contractor

SECTION PLAT

C E L NE NW
660 Ft. from N. Line
 _____ Ft. from S. Line
330 Ft. from E. Line
 _____ Ft. from W. Line

	o		

CUNNINGHAM POOL

Location _____

Rig up _____

Drilling and Remarks:

Rotary

RECORD

Cased _____ in., _____ ft.

Sand _____

Gas _____

Oil _____

Total Depth _____

PRODUCTION

1st 24 hrs. Nat. _____

1st 24 hrs. after shot _____

Gas _____ Cu. Ft.

Dry Hole _____

Abandoned _____

Date

FEB 26 1941 19

S. J. LEWIS Scout

Map No. 54 Sec. 25 Twp. 27 R. 11WWell No. 3 West Maxedon

Skelly Oil

Company

Contractor

COMPLETED

C E L NE NW

660 Ft. from N. Line

_____ Ft. from S. Line

330 Ft. from E. Line

_____ Ft. from W. Line

CUNNINGHAM POOL

SECTION PLAT

Location _____

Rig up _____

Drilling and Remarks:

*Log 8426 corrected**5' @ 3426**7000 cu. ft.**Flow 551 P.S.**17 1/2 M Gas**345 G.P.***RECORD**

Cased _____ in., _____ ft.

Sand _____

Gas _____

Oil _____

Total Depth 3491**PRODUCTION**

1st 24 hrs. Nat. _____

1st 24 hrs. after shot _____

Gas _____ Cu. Ft.

Dry Hole _____

Abandoned _____

Date

MAR 26 1941

S. J. LEWIS Scout