


Section 25 Township 27 Range 11WWell No. 8 C. J. MooreCompany Skelly Oil

NORTH

WEST

EAST

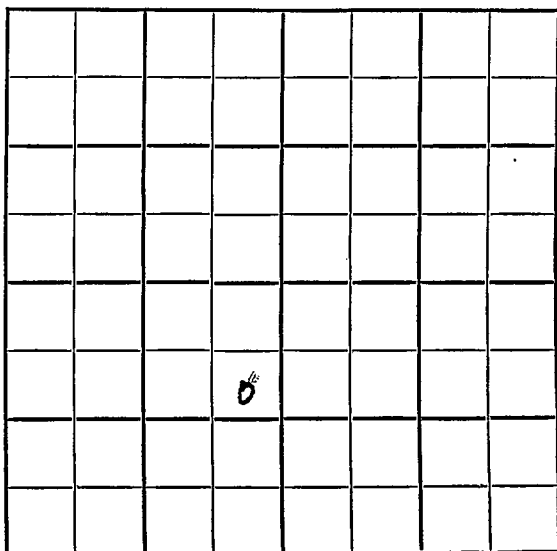

SOUTH

Pratt

KANSAS

SEC.	TWP.	R.
25 ¹	27	11W ✓

WELL NO.

8 C. J. Moore

FARM

COMPANY

Skelly Oil

CONTRACTOR


1050 Ft. from N. Line

Ft. from S. Line

305 Ft. from E. Line

Ft. from W. Line

SE NE SW

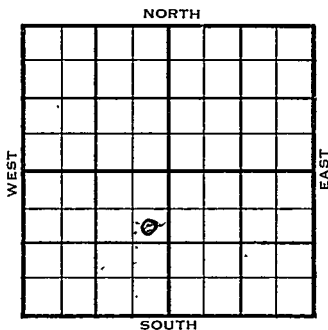

1954

ELEVATION

1670

REPORT

6/2 Location
 6/9 8" @ 516'
 D rlg. 2735'
 6/23 Spudding 5-30-54
 SWD well
 TD 3485
 8" @ 516
 Br. lime 3389 Lans. 3415
 TD 3417
 5" @ 3417
 DD 3438 DD 3461 B/2 go 18 gwph
 DD 3482 DD 3485 Comp. for SWD well

ABANDONED

County Pratt State KansasSec. 25 (Blk.) 27 (Sur.) 11W Map No.Operator Skelly OilWell No. 8 Farm C. J. MooreElev. Location SE NE SW

FIRST REPORT

0

1050 Ft. From N Line SW305 Ft. From E Line Quarter1st. Report JUN 2 1954

Completion

Remarks


Spudding Date

Drilg. Data

Location

J. G. WIGGILL

County Pratt State Kansas
 Sec. 25 (Blk. 27 (Sur. 11W Map No.
 Operator Skelly Oil
 Well No. 8 Farm C. J. Moore
 Elev. 1670 Location SE NE SW

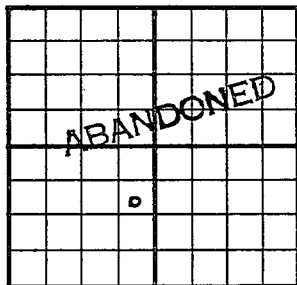

1050 ft. From N Line SW
305 ft. From E Line Quarter

1st. Report

Completion JUN 23 1954

Remarks

Spudding Date 5-30-54

Drlg. Data SWD well TD 3485
8" @ 516 Br. lime 3389 Lans. 3415
TD 3417 5" @ 3417 DD 3438 DD 3461
B/ 2 go 18 gwph DD 3482 DD 3485
Comp. for SWD well

J. G. McGEHEE