


KANSAS Pratt

Form 51-5M-7-40-Palace

Section 25 Township 27 Range 11-W

Well No. #5 Moore

Company Skelly Oil

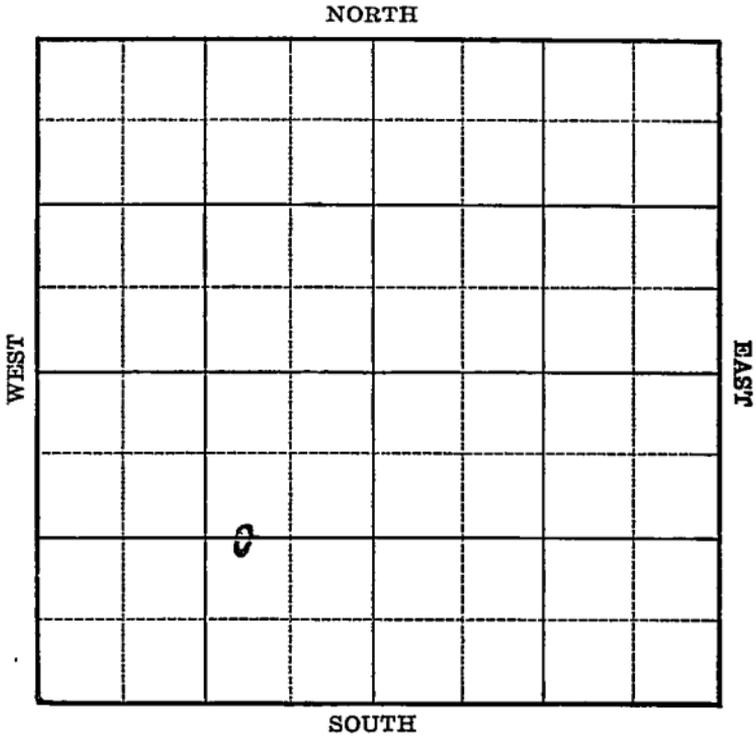

Sec. 25 Twp. 27 R. 11-W

Well No. #5 Moore Farm

Skelly Oil Company

(Cunningham)


_____ Ft. from N. Line

1320 Ft. from S. Line

990 Ft. from E. Line

_____ Ft. from W. Line

Elev. 1676

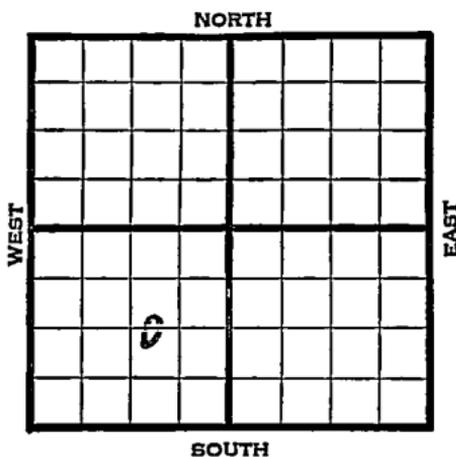

1941	REPORT
2/5	Rotary (Lans. test)
2/13	8" - 372' Drlg. 1425'
2/20	Drlg. 3240'
2/27	Lans. 3427' 5" - 3427'
	Drlg. 3454' S.O.
3/5	Lans. 3427'
	5" - 3427'
	P.D. 3488'
	7000 acid.
	Potential 588 bbls., pump & flow
	34.5 Gravity
	COMPLETED

Map No. ~~154~~ Sec. 25 Twp. 27 R. 11W

Well No. 5 Moore

Skelly Oil

Company

FIRST REPORT

Contractor

SECTION PLAT

C W L E $\frac{1}{2}$ SW

_____ Ft. from N. Line

1320 Ft. from S. Line990 Ft. from E. Line

_____ Ft. from W. Line

CUNNINGHAM POOL

Location _____

Rig up _____

Drilling and Remarks:

Rotary
Lansing test

RECORD

Cased _____ in., _____ ft.

Sand _____

Gas _____

Oil _____

Total Depth _____

PRODUCTION

1st 24 hrs. Nat. _____

1st 24 hrs. after shot _____

Gas _____ Cu. Ft.

Dry Hole _____

Abandoned _____

Date

FEB 5 1941 19

S. J. LEWIS

Scout

Map No. 54 Sec. 25 Twp. 27 R. 11W

Well No. 5 Moore

Skelly Oil Company

COMPLETION Contractor

SECTION PLAT

C W L E $\frac{1}{2}$ SW

 Ft. from N. Line

1320 Ft. from S. Line

990 Ft. from E. Line

 Ft. from W. Line

CUNNINGHAM POOL

Location

Rig up

Drilling and Remarks:

Lane 8427
5" @ 8427
7000 acil
Pump & Flow. 558

34.5 Gr

RECORD

Cased in., ft.

Sand

Gas

Oil

Total Depth 3487

PRODUCTION

1st 24 hrs. Nat.

1st 24 hrs. after shot

Gas Cu. Ft.

Dry Hole

Abandoned

Date

MAR 5 1941 19

S. J. LEWIS

Scout