

KANSAS


Pratt

FORM 51 5M 2-38 TPCO.

Section 25 Township 27 Range 11-W

Well No. 2 C. J. Moore

Company Skelly

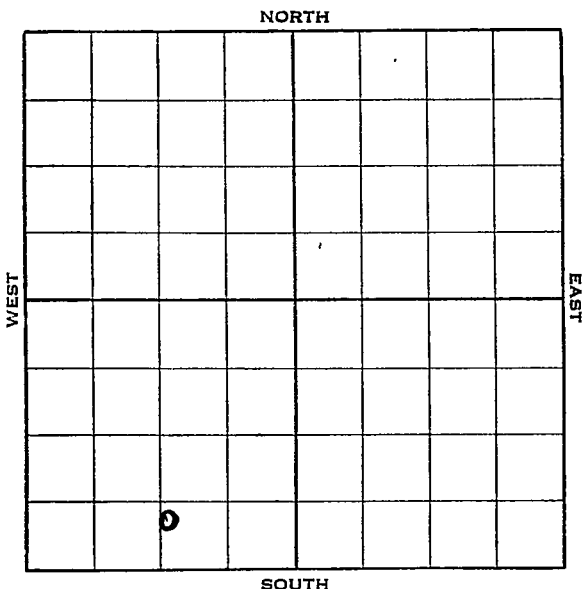

Pratt

KANSAS

Map No. 54 Sec. 25 Twp. 27 R. 11WWell No. 2 C. J. MooreSkelly

Company

Contractor

FIRST REPORT

C S L SW

Ft. from N. Line

440 Ft. from S. Line

Ft. from E. Line

1325 Ft. from W. Line

SECTION PLAT

Location X

Rig up

Drilling and Remarks:

RECORD

Cased _____ in., _____ ft.

Sand _____

Gas _____

Oil _____

Total Depth _____

PRODUCTION

1st 24 hrs. Nat. _____

1st 24 hrs. after shot _____

Gas _____ Cu. Ft.

Dry Hole _____

Abandoned _____

Date

SEP 21 1938 19H. D. Hatfield Scout

Map No. 54 Sec. 25 Twp. 27 R. 11WWell No. 2 C. J. MooreSkelly

Company

Contractor

COMPLETED

C S L SW

Ft. from N. Line

440

Ft. from S. Line

Ft. from E. Line

1325

Ft. from W. Line

SECTION PLAT

①

Location

Rig up

Drilling and Remarks:

7000 AcidPOT 825

RECORD

Cased 7 in., 3439 ft.Sand LENS 3438

Gas

Oil

Total Depth 3484

PRODUCTION

1st 24 hrs. Nat.

1st 24 hrs. after shot

Gas Cu. Ft.

Dry Hole

Abandoned

Date

NOV 2 - 193819H. D. Hatfield

Scout