

# KANSAS

Form 51-5M-7-39-Palace


Pratt.

Section 25 Township 27 Range 11-W

Well No. #3 C. J. Moore

Company Skelly

NORTH **Cunningham Pool**

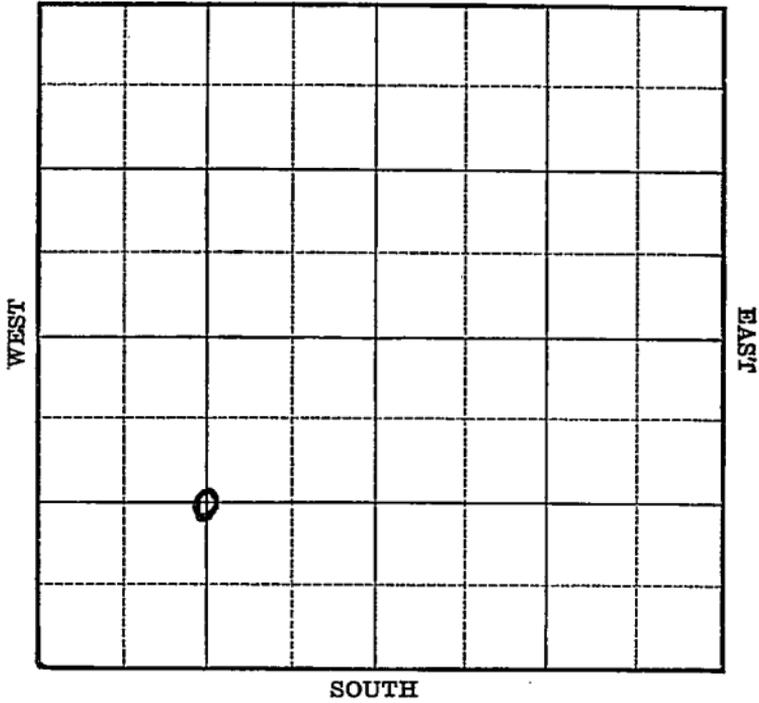

Sec. 25 Twp. 27 R. 11-W

Well No. #3 C. J. Moore Farm

Skelly Company

(Cunningham)


           Ft. from N. Line

1320 Ft. from S. Line

           Ft. from E. Line

1320 Ft. from W. Line

Elev. 1675

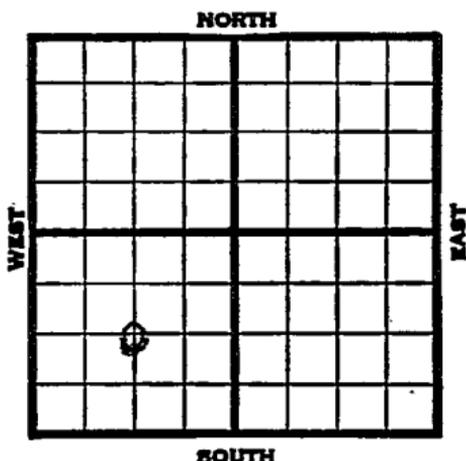

1939	REPORT
9/13	Cellar.
9/21	10" - 360' WOC.
9/28	Drlg. 2490'
10/5	Drlg. 3743'
10/12	Kinderhook 2987' Viola 4048'
	5" - 4050' T.D. 4051' RUST.
10/19	Drlg. 4062'
10/25	Viola 4048'
	5" - 4050'
	T.D. 4066'
	1000 acid.
	109,177,760 cu. ft. gas.
	1300# rock pressure.
	COMPLETED

Map No. 54 Sec. 25 Twp. 27 R. 11WWell No. 3 C. J. MooreSkelly Company

Contractor

## FIRST REPORT

C SW

## SECTION PLAT


       Ft. from N. Line1320 Ft. from S. Line       Ft. from E. Line1320 Ft. from W. Line

## CUNNINGHAM POOL

Location       Rig up       

Drilling and Remarks:

. Cellar

## RECORD

Cased        in.,        ft.Sand       Gas       Oil       Total Depth       

## PRODUCTION

1st 24 hrs. Nat.       1st 24 hrs. after shot       Gas        Cu. Ft.Dry Hole       Abandoned       

Date

SEP 13 1939

19

S. J. LEWIS

Scout

Map No. 54 Sec. 25 Twp. 27 R. 11W

Well No. 3 C. J. Moore

Skelly

Company

Contractor

**COMPLETED**

**C SW**

\_\_\_\_\_ Ft. from N. Line

1320 Ft. from S. Line

\_\_\_\_\_ Ft. from E. Line

1320 Ft. from W. Line

**CUNNINGHAM POOL.**

**SECTION PLAT**


Location \_\_\_\_\_

Rig up \_\_\_\_\_

Drilling and Remarks:

*Vidla 4048*  
*5" C 4050*  
*1000 acid*  
*109,177,760 cu ft*  
*Gas*  
*1300<sup>th</sup> R. P.*

**RECORD**

Cased \_\_\_\_\_ in., \_\_\_\_\_ ft.

Sand \_\_\_\_\_

Gas \_\_\_\_\_

Oil \_\_\_\_\_

Total Depth 4066

**PRODUCTION**

1st 24 hrs. Nat. \_\_\_\_\_

1st 24 hrs. after shot \_\_\_\_\_

Gas \_\_\_\_\_ Cu. Ft.

Dry Hole \_\_\_\_\_

Abandoned \_\_\_\_\_

Date

OCT 25 1939

Scout