

KANSAS

Form 51-5M-7-39-Palace


Pratt

Section 25 Township 27 Range 11-W

Well No. #4 C. J. Moore

Company Skelly

NORTH **Cunningham Pool**

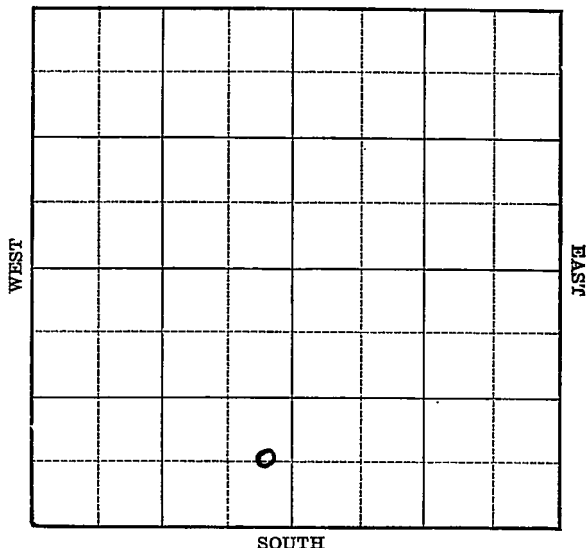

Map No. 54 Sec. 25 Twp. 27 R. 11WWell No. 4 C. J. Moore

Skelly

Company

Contractor

FIRST REPORT

C E L SE SW

_____ Ft. from N. Line

660 Ft. from S. Line330 Ft. from E. Line

_____ Ft. from W. Line

Cunningham Pool

SECTION PLAT

Location _____

Rig up _____

Drilling and Remarks:

8" - 373

WOC

RECORD

Cased _____ in., _____ ft.

Sand _____

Gas _____

Oil _____

Total Depth _____

PRODUCTION

1st 24 hrs. Nat. _____

1st 24 hrs. after shot _____

Gas _____ Cu. Ft.

Dry Hole _____

Abandoned _____

Date

JUN 12 1940

S. J. LEWIS Scout

Map No. 54 Sec. 25 Twp. 27 R. 11^W

Well No. 4 C.J. Moore

Skelly Company

Contractor

COMPLETED

C E L S E S W

 Ft. from N. Line

660 Ft. from S. Line

330 Ft. from E. Line

 Ft. from W. Line

CUNNINGHAM POOL

SECTION PLAT

Location

Rig up

Drilling and Remarks:

*Lane 3424
5" @ 3428 1/2
4000 acid
Pump 541 P.S.*

RECORD

Cased in., ft.

Sand

Gas

Oil

Total Depth 3484'

PRODUCTION

1st 24 hrs. Nat.

1st 24 hrs. after shot

Gas Cu. Ft.

Dry Hole

Abandoned

Date

JUL 2 1940 19

S. J. LEWIS Scout