

Ford


Form 51-5M 5-37 Petrol

KANSAS

Section 26 Township 27 Range 22-W

Well No. 1 - Fowler

Company Olson et al

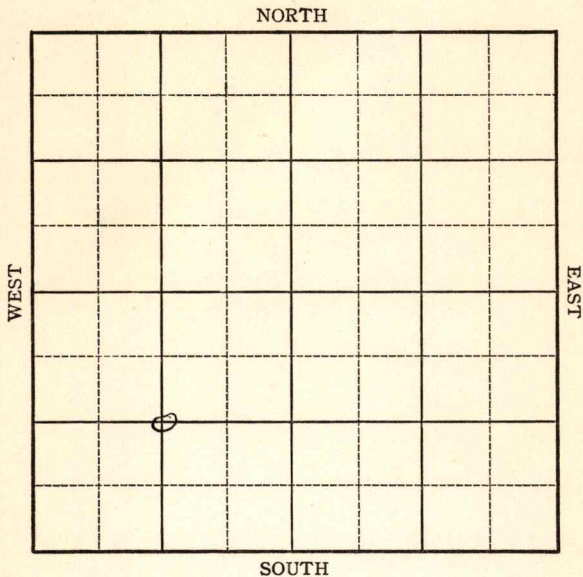

1937

12/8 Viola 5655'.

Simp. 5805'.

Sil. 5832'.

T.D. 5907'.

Only small stain oil in Sil.

ABANDONED

Map No. 89 Sec. 26 Twp. 27 R. 22WWell No. 1-FowlerOlson et al Company


Contractor

FIRST REPORT

C SW

 Ft. from N. Line1320 Ft. from S. Line Ft. from E. Line1320 Ft. from W. Line

SECTION PLAT

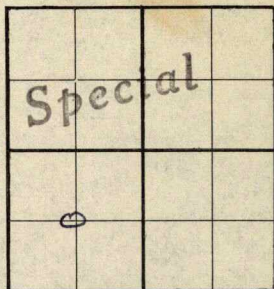Location Rig up

Drilling and Remarks:

RR

RECORD

Cased in., ft.Sand Gas Oil Total Depth

PRODUCTION

1st 24 hrs. Nat. 1st 24 hrs. after shot Gas Cu. Ft.Dry Hole Abandoned

Date

SEP 29 1937 19H. D. Hatfield Scout

Ford

KANSAS

Map No. 89 Sec. 26 Twp. 27 R. 22WWell No. 1 FowlerOlson etal

Company

Contractor

ABANDONED

C SW

 Ft. from N. Line1320 Ft. from S. Line Ft. from E. Line1320 Ft. from W. Line

SECTION PLAT

Location Rig up

Drilling and Remarks:

*Viola 5655**Simp 5805**Sil. 5832**T.D. 5907**only small stain oil in sil.**DVA*

RECORD

Cased in., ft.Sand Gas Oil Total Depth 5907

PRODUCTION

1st 24 hrs. Nat. 1st 24 hrs. after shot Gas Cu. Ft.Dry Hole Abandoned

Date

DEC 8 - 1937

19

H. D. Hatfield

Scout