


Section 26 Township 27 Range 5W
Well No. 1 Bonjour
Company F. K. Johnson

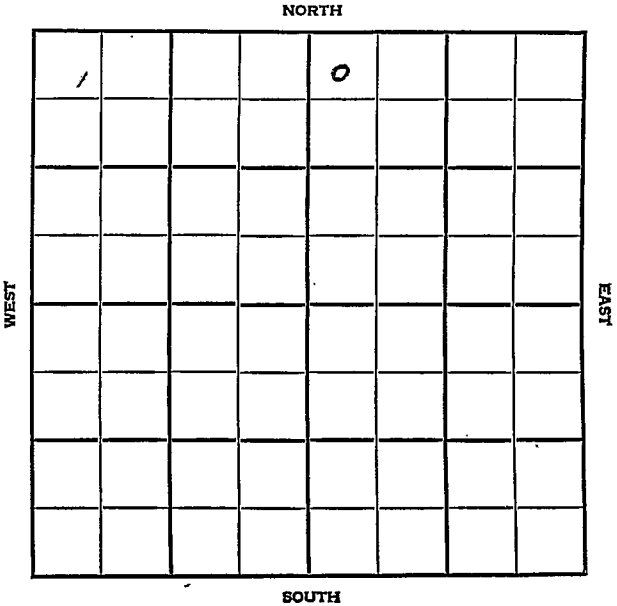

Kingman

KANSAS

SEC.	TWP.	R.
26	27	5 W

WELL NO.

1 Bonjour

FARM

COMPANY

F. K. Johnson

CONTRACTOR

Musgrove

Wildcat


330 Ft. from N. Line

Ft. from S. Line

Ft. from E. Line

330 Ft. from W. Line

NW NW NE

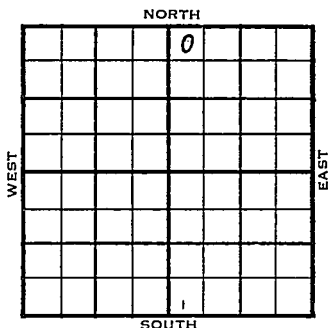

1954

ELEVATION

1494'

REPORT

12/15

Spud 12-13-54

Rng. surface pipe.

12/29

Spud 12-13-54

8" @ 205'

Lans 2960', Miss 3766'

TD 3873'

D&A

ABANDONED

FREDEN GILSTRAP





France Man

Pierce Map

WISC.

DEC 20 1954

Drig. Data

FABEN GILSTRAP

JAN 4 1955

Sevent Cards	_____
Land Small Map	_____
Land Wall Map	_____
Trachys	_____
France Map	_____
Picture Map	_____
Misc	_____

Drig. Data